
KANSAS

DX 78-1 Cowley

Section 10 Township 31 Range 3E

Well No. #2 Mowder

Company Beaumont Pet.

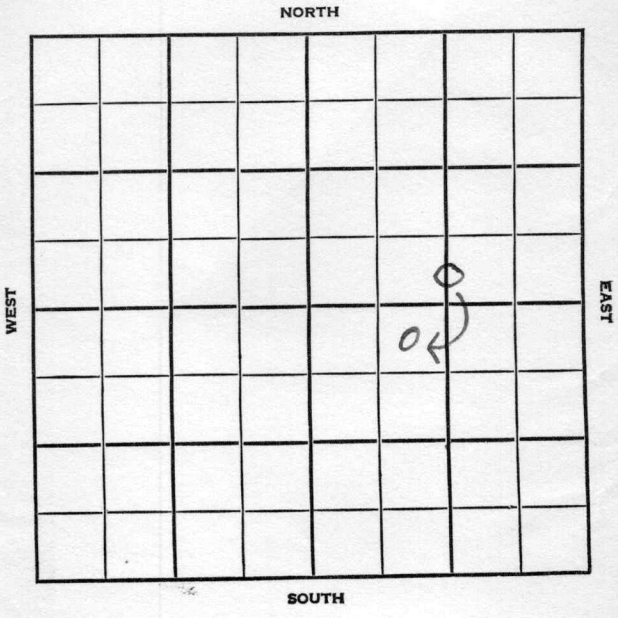

Cowley KANSAS

SEC.	TWP.	R.
10	31	3E

WELL NO.

2 Mowder FARM

COMPANY

Beaumont Pet.

CONTRACTOR

Co. Tools

Smith

330 Ft. from N. Line


Ft. from S. Line

Ft. from E. Line

1100 Ft. from W. Line

~~C S½ S½ NE~~

NE NW SE

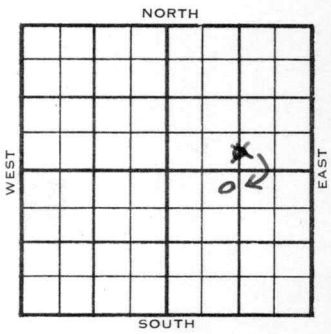

1955	ELEVATION 1251' REPORT
6/15	Comm 6-10-55 ~~82~~ 8" @ 132/100 Drlg 2300
8/3	DST 3036-70 open 45 min. Rec. 30' socm 40/15" 4½" @3142 CP 3040-47 250 A frac P/20 bopd Comp.

C. Bart	3036	1785
M.	3091	1840
TD.	3142	

COMPLETED

DX-78

FORM 513 REV. SUNRAY

County Cowley Elev.

Sec. 10 Twp. 31 Rge. 3E

Company Beaumont Pet.

Farm Name Mowder No. 2

TOPS	DEPTH	LOG	DATUM
Anh.			
T.P.			
H.			
Tr.			
Dg.			
B.L.			
L.			
K.C.			
B.K.C.			
Ce.			
C.			
M.			
M.			
K.			
Mz.			
Mo.			
V.			
S.			
S.			
A			
R.			
P€.			
G.			
T.D.			

Loc. in Sec. C S½ S½ NE

Geol.

Contr. Co. tools

Pool Smith

FIRST REPORT

JUN 15 '55

Date Comm. 6-10-55

8" @ 132/100 drlg. 2300

Co. Lse. No. Sec. T. R.

SCOUT TICKET DX-201

Kansas

SEC.	TWP.	R.
10	31	3E

WELL NO.

2 Mowder FARM

COMPANY

Beaumont Pet.

CONTRACTOR

CORRECTION


NE NW SE

330 FT. FROM N. LINE

_____ FT. FROM S. LINE

_____ FT. FORM E. LINE

1100 FT. FROM W. LINE

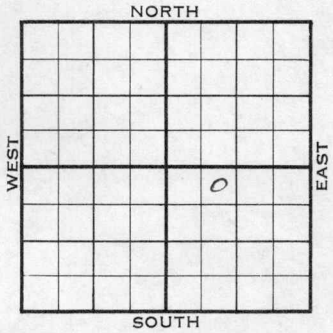

Cowley County

☐ LOCATION

☐ RIG UP

DRILLING AND REMARKS:

Reported
C S½ S½ NE

RECORD

CASED IN., FT.
SAND
GAS
OIL
TOTAL DEPTH

PRODUCTION

1ST 24 HRS. NAT.
1ST 24 HRS. AFTER SHOT
GAS CU. FT.
DRY HOLE
ABANDONED

DATE AUG 29 1955

SCOUT L. J. Harris

FORM 513 REV. SUNRAY

County Cowley Elev. 1251

Sec. 10 Twp. 31 Rge. 3E

Company Beaumont Pet.

Farm Name Mowder No. 2

TOPS	DEPTH	LOG	DATUM
Anh.			
T.P.			
H.			
Tr.			
Dg.			
B.L.			
L.			
K.C.			
B.K.C.			
Ce.			
C. Bart	3036		1785
M.			
M.	3091		1840
K.			
Mz.			
Mq.			
V.			
S.			
S.			
A			
R.			
P€.			
G.			
T.D.	3142		

Loc. in Sec. NE NW SE

1100' WL

Geol.

Contr. Co. tools

Pool Smith

COMPLETE

Date Comm. 6-10-55 AUG 3 1955

8" @ 132/100 DST 3036-70 open 45 min.

Rec. 30' socm 40/15" 4½"@ 3142

CP 39/ 3040-47 250 A frac

P/ 20 bopd Comp.

Co. Lse. No. Sec. T. R.