

Cowley


KANSAS

Form 51-5M 5-37 Petrol

Section 8 Township 31 Range 3-E

Well No. 1 Fry

Company C. E. Roth

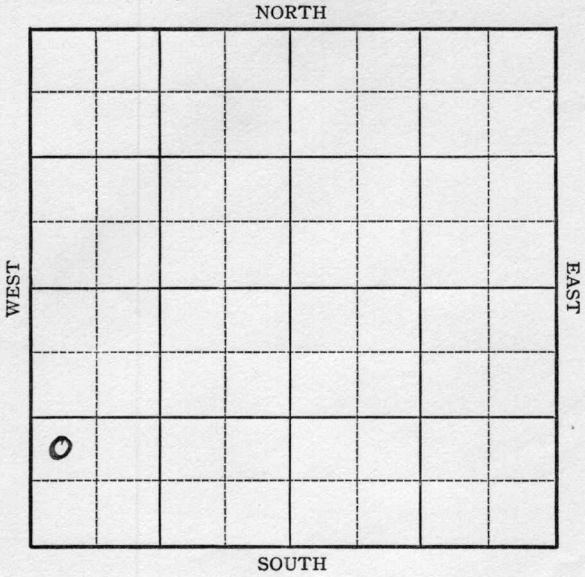

Sec. 8 Twp. 31 R. 3-E

Well No. #1 Fry Farm _____
C. E. Roth Company _____


_____ Ft. from N. Line

990 Ft. from S. Line

_____ Ft. from E. Line

330 Ft. from W. Line

Elev. 1250

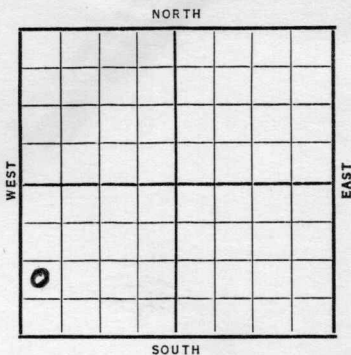

Date	REPORT
1937	
11/10	Mch. Spud & SD.
11/19	Drlg. 700'.
11/26	" "
12/3	Drlg. 1150'.
12/10	10" @ 1500'. Drlg. 1540'.
12/17	U. R. 8" @ 1830'.
12/24	" " "
12/31	" " "
1938	
1/5	6" @ 2500'.
	K.C. 2450-62'.
	T.D. 2660'.
	COMPLETED

Cowley

KANSAS

Map No. 1 Sec. 8 Twp. 31 R. 3E

Well No. 1 Fry

C. E. Roth Company

Contractor

FIRST REPORT

NW SW SW

 Ft. from N. Line

990 Ft. from S. Line

 Ft. from E. Line

330 Ft. from W. Line

SECTION PLAT

●			

Location

Rig up

Drilling and Remarks:

Mch. Spud & S.D.

RECORD

Cased in., ft.

Sand

Gas

Oil

Total Depth

PRODUCTION

1st 24 hrs. Nat.

1st 24 hrs. after shot

Gas Cu. Ft.

Dry Hole

Abandoned

Date

NOV 10 1937 19

H. D. Hatfield Scout

