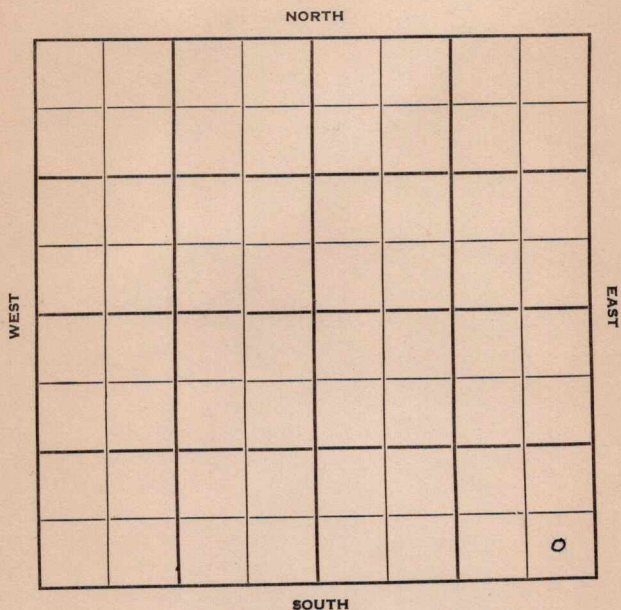


KANSAS

Barton

Section 19 Township 20 Range 12-WWell No. #1 BatchmanCompany Anchultz Drlg.

Barton

KANSAS

Sec. 19 Twp. 20 R. 12W ✓

Well No. #1 Batchman Farm

Anchultz Drlg.

Company

Contractor

Wildcat


Ft. from N. Line

330' Ft. from S. Line

330' Ft. from E. Line

Ft. from W. Line

SE SE SE

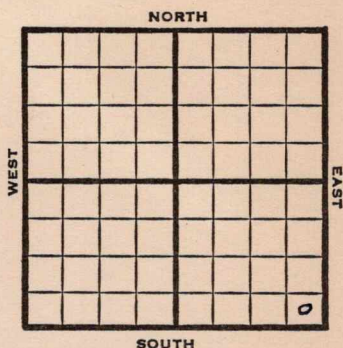

1950

Elev 1856

REPORT

5/31

Spud 5-28-50

8" @ 265'

WOC

7/19

8 1/4" @ 265

Anhy 670-700

Br lime 3190

Lans 3203

SO 3332-39,

DST 3330-40, opn 1 hr rec 70' mud & SW

Arb 3458

TD 3463

DST 3458-63, opn 30 min rec 20' mud

5" @ 3459

DD 3469

500 acid

DD 3480

700 acid

S/8-9 boph 2 hr

S/35 bo 6 1/2 hr

1500 acid

S/40 1/2 bo 7 1/2 hr

S/16 bo 2 hr

Comp 180 bopd 35.5 gravity

Completed

COMPLETED

Map No. _____ Sec. 19 Twp. 20 R. 12W

Well No. 1 Batchman

Anchultz Drlg.

Company _____

Contractor _____

SE SE SE

SECTION PLAT

FIRST REPORT

_____ Ft. from N. Line

330 Ft. from S. Line

330 Ft. from E. Line

_____ Ft. from W. Line

Barton

Derby D H M

Location _____

Rig up _____

Drilling and Remarks:

Spud 5-28-50

8" c 265

W. O. C.

RECORD

Cased _____ in., _____ ft.

Sand _____

Gas _____

Oil _____

Total Depth _____

PRODUCTION

1st 24 hrs. Nat. _____

1st 24 hrs. after shot _____

Gas _____ Cu. Ft.

Dry Hole _____

Abandoned _____

Date

MAY 31 1950

19

J. E. TYRA

Scout

Kansas

Map No. _____ Sec. 19 Twp. 20 R. 12WWell No. 1 BatchmanAnschutz Drlg.

Company _____

Contractor _____

SE SE SE

El. 1856
SECTION PLAT

_____ Ft. from N. Line

330 Ft. from S. Line330 Ft. from E. Line

_____ Ft. from W. Line



Barton County

Location _____

Rig up _____

Drilling and Remarks:

8 $\frac{1}{4}$ " @ 265

Anhy 670-700

Br. lime 3190

Lans. 3203

SO 3332-39

DST 3330-40

open 1 hr.

RECORD

Cased _____ in., _____ ft.

Sand _____

Gas _____

Oil _____

Total Depth 3480

PRODUCTION

1st 24 hrs. Nat. _____

1st 24 hrs. after shot _____

Gas _____ Cu. Ft.

Dry Hole _____

Abandoned _____

Rec. 70' mud & SW

Date

JUL 19 1930

19

J. E. TYRA

Scout

Arb. 3458

TD 3463

DST 3458-63

open 30 min.

Rec. 20' mud

5" @ 3459

DD 3469

500 acid

DD 3480

700 acid

S/ 8-9 boph 2 hr.



S/ 35 bo $6\frac{1}{2}$ hr.

1500 acid

S/ $40\frac{1}{2}$ bo $7\frac{1}{2}$ hr.

S/ 16 bo 2 hr.

Comp. 180 bopd 35.5 gravity

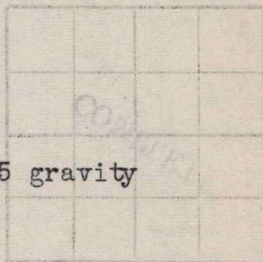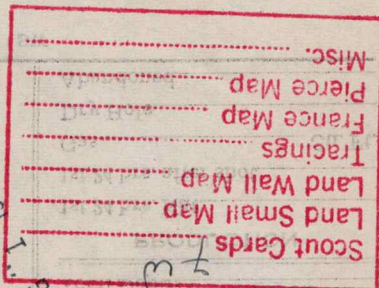

742708