


Section 10 Township 31 Range 3E

Well No. 1 Satterthwaite

Company K. T. Weidemann

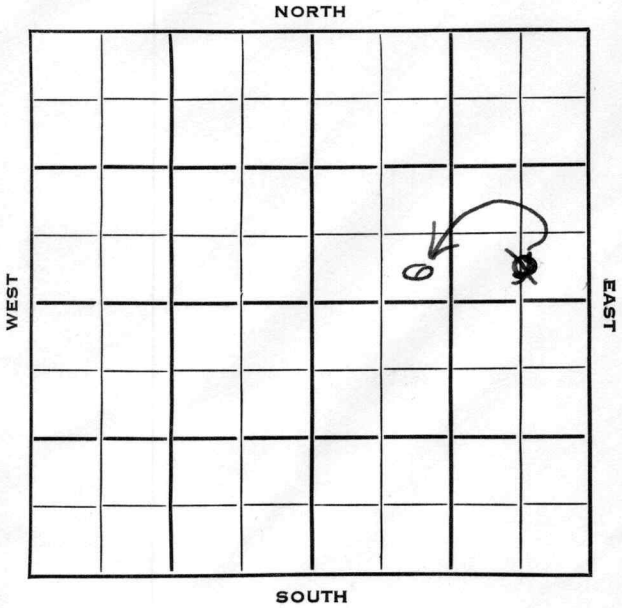

Sec. 10 Twp. 31 R. 3 E

Well No. # 1 Satterthwaite Farm

K. T. Weidemann Company

Smith Pool Contractor

Ft. from N. Line

200

Ft. from S. Line


~~330~~

Ft. from E. Line

1400
~~660~~

Ft. from W. Line

~~C SL SE NE~~
SE SW NE

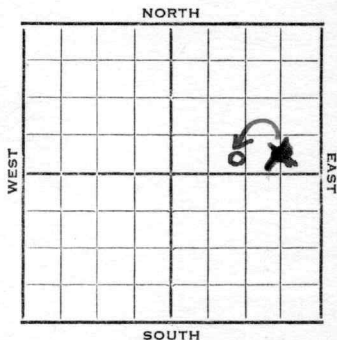

REPORT

1952

Elev. 1238'

11/26

Spud 11-20-52
8" @ 145
Dr1g. 1475'

1953

1/28

Spud 11-20-52 Oil well TD 3039'
8" @ 145 KC 2487' Cherokee 2925'
Bart 3017' TD 3019' 5" @ 3018'
DD 3039' 3-hydro.
Comp. 15 BOPD 15 BW

COMPLETED

County **Cowley** State **Kansas**

Sec. **10** (Blk.) **31** (Sur.) **3E** Map No.

Operator **K. T. Weidemann**

Well No. **1** Farm **Satterthwaite**

Elev. Location **C S L SE NE**

330 Ft. From **S** Line **NE**

660 Ft. From **E** Line Quarter

1st. Report **NOV 26 1952**

Completion

Remarks

Spudding Date **11-20-52**

Drlg. Data **Smith Pool**

8" 145 drlg. 1475

County Cowley State Kansas

Sec. 10 (Blk.) 31 (Sur.) 3E (Twp.) 3E Map No.

Operator K. T. Weidemann

Well No. 1 Farm Satterthwaite

Elev. 1238 Location SE SW
SW SE NE

CORRECTION				
		0	X	
COMPLETE				

²⁰⁰~~330~~ Ft. From S Line NE
¹⁴⁰⁰~~990~~ Ft. From E Line Quarter

1st. Report

Completion JAN 28 1953

Remarks Smith Pool

Spudding Date 11-20-52

Drlg. Data Oil well TD 3039

8" @ 145 KC 2487 Cherokee 2925

Bart. 3017 TD 3019 5" @ 3018

DD 3039 3-hydro. Comp. 15 bopd 15 bw

Your 1st report shows 330' x 660'

You complete 330' x 990'

Advise

Sam

Scout Cards	<i>mm</i>
Land Small Map	
Land Wall Map	<i>6</i>
Tracings	
France Map	
Pierce Map	
1953	

FEB 6 1953

Drig. Data