


DX 78-1

Cowley

Section 10 Township 31 Range 3E

Well No. #2 Satterthwaite

Company K. T. Weidemann

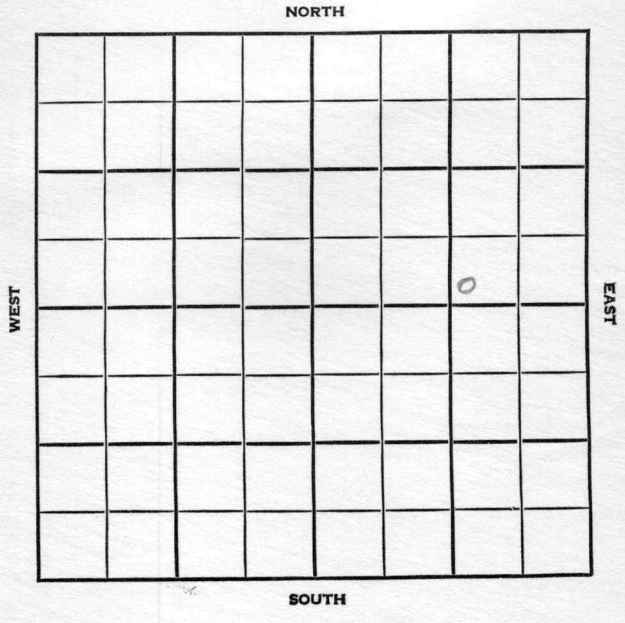

Cowley

KANSAS

SEC.	TWP.	R.
10	31	3 E

WELL NO. # 2 Satterthwaite FARM

COMPANY K. T. Weidemann

CONTRACTOR Co. tools

Smith


_____ Ft. from N. Line

_____ Ft. from S. Line

_____ Ft. from E. Line

_____ Ft. from W. Line

C S $\frac{1}{2}$ SE NE

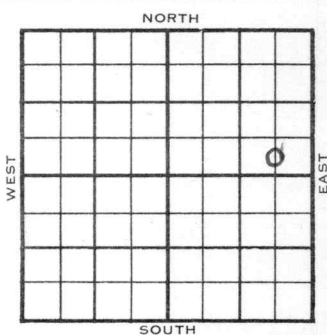

1955	ELEVATION 1247'	REPORT
------	--------------------	--------

6/8
Comm. 6-2-55
8" @ 141 w/100
Drlg. 1725'

8/10
5 $\frac{1}{2}$ " @3021 DD 3029 DD 3035, PB: 3032m
PB: 3032, PB 3027, Comp. 10 bopd 5 bw.
KC: 2489, 1242; BEC. 2753, 1506;
Ce. Bart: 3019, 1772; TD: 3021.

COMPLETED

County Cowley Elev. 1247
 Sec. 10 Twp. 31 Rge. 3E
 Company K. T. Weidemann
 Farm Name Satterthwaite No. 2

TOPS	DEPTH	LOG	DATUM
Anh.			
Tp.			
H.			
Tr.			
Dg.			
Bl.			
L.			
K.C.	<u>2489</u>		<u>1242</u>
B.K.C.	<u>2753</u>		<u>1506</u>
Ce. <u>Best</u>	<u>3019</u>		<u>1772</u>
C.			
M.			
M.			
K.			
Mz.			
Me.			
V.			
S.			
S.			
A.			
R.			
PE.			
G.			
T.D.	<u>3021</u>		

Loc. in Sec. C S¹/₂ SE NE

Geol. _____

Contr. _____

Co. tools

Pool _____

Smith

COMPLETE 0		
---------------	--	--

Date Comm. 6-2-55 AUG 10 1955

8" @ 141/100 5¹/₂" @ 3021 DD 3029

DD 3035 PB 3032 PB 3027

Comp. 10 bopd 5 bw

Co.

Lse.

No.

Sec.

T.

R.