


Section 13 Township 27 Range 7 EWell No. # 2 SewardCompany Sunflower Drlg.

NORTH

WEST

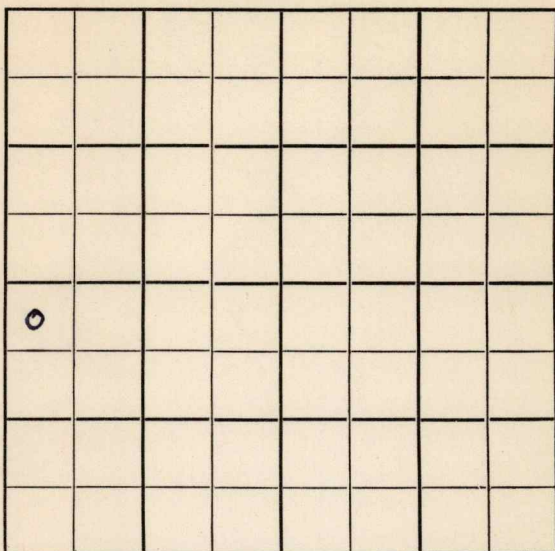

EAST

SOUTH

Butler

KANSAS

Sec. 13 Twp. 27 R. 7E

Well No. #2 Seward Farm

Sunflower Drlg.

Company

Contractor


330' Ft. from N. Line

Ft. from S. Line

Ft. from E. Line

330' Ft. from W. Line

NW NW SW

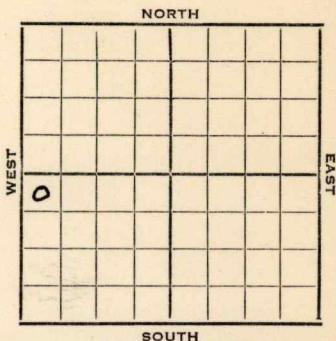

1951

Elev. 1447'

REPORT

12/19

5"

1952

1/16

Oil well . TD 2566' 10" @ 98

Sand 2556' 5" @ 2558-66' TD

20 qt/ Comp. 15 BOPD

COMPLETED

County **Butler** State **Kansas**

Sec. **13** (Blk. Twp.) **27** (Sur. Rge.) **7E** Map No.

Operator Sunflower Drlg.

Well No. **2** Farm **Seward**

Elev. 1447 Location NW NW SW

FIRST REPORT

330 Ft. From N Line SW

330 Ft. From W Line Quarter

1st. Report DEC 1 9 1951

Completion

Remarks

Spudding Date _____

Drlg. Data

5th

J. E. TYRA

