


Cowley

Map No. KANS Sec. 10 Twp. 31 R. 3E
Well No. 6 Shaffer Farm
Benedict Trees Company

NORTH

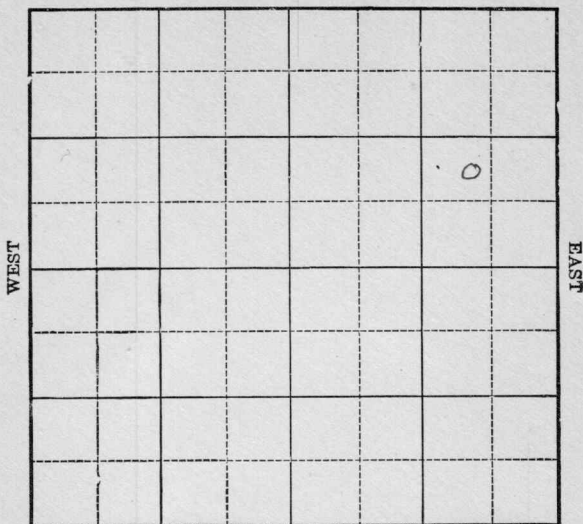

SOUTH

Location _____

Drilling Remarks _____

Rig Up _____

Drilling Remarks _____

RECORD

Cased _____ in. _____ ft.

Sand _____

Gas _____

Oil _____

Total Depth _____

PRODUCTION

1st 24 hrs. Nat. _____

1st 24 hrs. after shot _____


Gas _____ cu. ft.

Dry Hole _____

Abandoned _____

Map No. *Kansas* Sec. *10* Twp. *31* R. *3E*Well No. *6 Shaffer* Farm*Benedum Trees* Company

NORTH

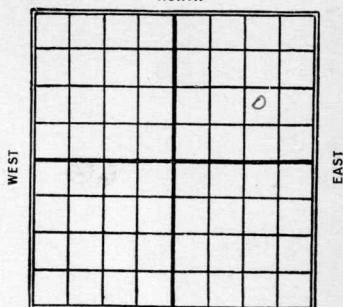

SOUTH

Ft. from N. Line

910 Ft. from S. Line*990* Ft. from E. Line


Ft. from W. Line

Date

REPORT

<i>1926</i>	
<i>6/30</i>	<i>R.O.G.</i>
<i>7/14</i>	<i>same</i>
<i>7/22</i>	<i>Spud</i>
<i>7/28</i>	<i>Drlg 700</i>
<i>8/4</i>	<i>" 1300</i>
<i>8/11</i>	<i>" 1600</i>
<i>8/18</i>	<i>" 2220</i>
<i>8/25</i>	<i>" 2700</i>
<i>9/1</i>	<i>" 2750</i>
<i>9/8</i>	<i>" 2900</i>
<i>9/15</i>	<i>no report</i>
<i>9/22</i>	<i>Set 6" top line 3080</i>
<i>9/29</i>	<i>Drlg 3100</i>
<i>10/6</i>	<i>F.D. 3320-5D.</i>
<i>10/13</i>	<i>Wilcox 3380-H.F.W.</i>
	<i>Plugging back</i>
<i>10/20</i>	<i>Plug back to 3000</i>
<i>10/27</i>	<i>Plugging back to 3000</i>
<i>11/3</i>	<i>P.B. to 3005</i>
<i>11/10</i>	<i>same</i>
<i>11/17</i>	<i>—</i>
<i>11/24</i>	<i>C.O.</i>

12/8-T. D. 3382' D. + A.

 

K1
 Map No. KANSAS Sec. 10 Twp. 31 R. 3E

Well No. 6 Shaffer

Benedum Trees Company

Contractor

SECTION PLAT

_____ Ft. from N. Line

910 Ft. from S. Line

990 Ft. from E. Line

_____ Ft. from W. Line

			o

FIRST REPORTS

Location _____

Rig up _____

Drilling and Remarks:

ROG.

80 ft south of
No 3.

RECORD

Cased _____ in., _____ ft.

Sand _____

Gas _____

Oil _____

Total Depth _____

PRODUCTION

1st 24 hrs. Nat. _____

1st 24 hrs. after shot _____

Gas _____ Cu. Ft.

Dry Hole _____

Abandoned _____

Date

JUN 30 1926

192

S. J. LEWIS

Scout

Map No. 1 Sec. 10 Twp. 31 R. 3E

Well No. 6 Shaffer

Benedum Trees Company

Contractor

SECTION PLAT

_____ Ft. from N. Line

910 Ft. from S. Line

990 Ft. from E. Line

_____ Ft. from W. Line

ABANDONED

			0

Location _____

Rig up _____

Drilling and Remarks:

TH 3382.

II 8 A.

RECORD

Cased _____ in., _____ ft.

Sand _____

Gas _____

Oil _____

Total Depth _____

PRODUCTION

1st 24 hrs. Nat. _____

1st 24 hrs. after shot _____

Gas _____ Cu. Ft.

Dry Hole _____

Abandoned _____

Date

DEC 8 - 1926

S. J. LEWIS

Scout