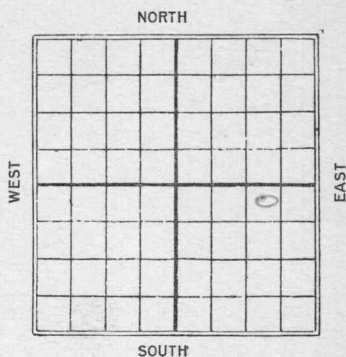


Map No. 1 Kansas Sec. 10 Twp. 31 R. 3Well No. 2 Smith Farm
Tree Oil Company330 Ft. from N. Line

Ft. from S. Line

990 Ft. from E. Line

Ft. from W. Line

BeneathDate 1925 REPORT4/23 Location6/5 Trg Coy 18407/5 21807/22 S. 3017-37-I.D. 3040-
1000' Oil in Hole7/29 shot 30 gts 2900 oil in
hole C.O.8/5 Sand 3017-37-I.D. 3040
60/gts / 110 lbs.

1 **KANSAS** Map No. _____ Sec. 10 Twp. 31 R. 3

Well No. 2 Smith _____

Tree Oil _____ Company

_____ Contractor

FIRST REPORT

SECTION PLAT

330' Ft. from N. Line

_____ Ft. from S. Line

990' Ft. from E. Line

_____ Ft. from W. Line

			0

Location ✓✓ _____

Rig up _____

Drilling and Remarks:

RECORD

Cased _____ in., _____ ft.

Sand _____

Gas _____

Oil _____

Total Depth _____

PRODUCTION

1st 24 hrs. Nat. _____

1st 24 hrs. after shot _____

Gas _____ Cu. Ft.

Dry Hole _____

Abandoned _____

Date

APR 23 1925

192

M. A. BENEAR

Scout

Map No. **KANSAS** Sec. 10 Twp. 31 R. 32

Well No. 2 Smith

Trees Oil Company

Contractor

SECTION PLAT

COMPLETED

336 Ft. from N. Line

_____ Ft. from S. Line

990 Ft. from E. Line

_____ Ft. from W. Line

			0

Location _____

Rig up _____

Drilling and Remarks:

Shot 60 gts.

RECORD

Cased _____ in., _____ ft.

Sand 3017-37

Gas _____

Oil _____

Total Depth 3040

PRODUCTION

1st 24 hrs. Nat. _____

1st 24 hrs. after shot 110

Gas _____ Cu. Ft.

Dry Hole _____

Abandoned _____

Date

AUG 5 1925

O. J. Lewis Scout

Map No. Kansas Sec. 10 Twp. 31 R. 3Well No. 2 SmithTrees Oil Company

Contractor

SECTION PLAT

330 Ft. from N. Line

Ft. from S. Line

990 Ft. from E. Line

Ft. from W. Line

COMPLETED

			0

Location

Rig up

Drilling and Remarks:

Sand 3017-37T.D. 304060 gts 110 Bbls

RECORD

Cased _____ in., _____ ft.

Sand _____

Gas _____

Oil _____

Total Depth _____

PRODUCTION

1st 24 hrs. Nat. _____

1st 24 hrs. after shot _____

Gas _____ Cu. Ft.

Dry Hole _____

Abandoned _____

Date

8/5 1925

S. J. LEWIS

Scout