


Map No. Kans Sec. 10 Twp. 31 R. 3E

Well No. 4 S. R. Smith Farm

Bendums & Trees Company

NORTH

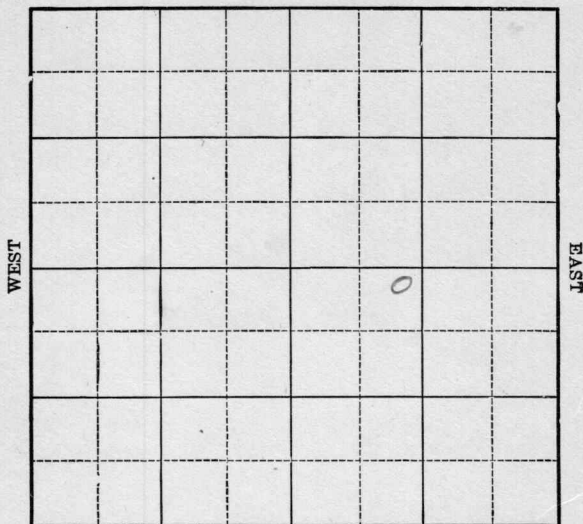

SOUTH

Location _____

Drilling Remarks

Rig Up

Drilling Remarks

RECORD

Cased_____in. _____ft.

Sand -----

Gas _____

Oil _____

Total Depth

PRÉDUCTION

1st 24 hrs. Nat.

1st. 24 hrs. after shot.....

Gas _____ cu. ft.

Dry Hole

Abandoned -----


Map No. *Kaw* Sec. *10* Twp. *31* R. *3^E*Well No. *4* *S R Smith* Farm*Benedum & Drees* Company*330* Ft. from N. Line

Ft. from S. Line

Ft. from E. Line

990 Ft. from W. Line

NORTH

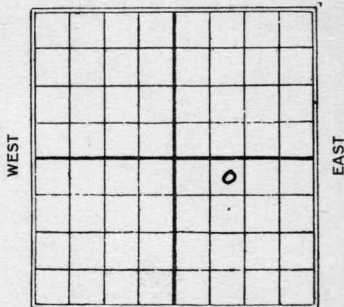

SOUTH

L

Date REPORT

*1925**7/29 Location**8/7**8/14**8/19**8/26**9/2**9/9**9/16**9/24**9/30**10/6**10/13**10/21**11/11**11/18**2/3 Top sand 3041**Bottom sand 3056**T.O. 3058**shot 25 qt 75 bbb*

Map No. KANSAS Sec. 10 Twp. 31 R. 3EWell No. 4 RR SmithBenedum Trees Company

Contractor

FIRST REPORT

SECTION PLAT

380 Ft. from N. Line

Ft. from S. Line

Ft. from E. Line

990 Ft. from W. Line

		0	

Location ✓

Rig up

Drilling and Remarks:

RECORD

Cased _____ in., _____ ft.

Sand _____

Gas _____

Oil _____

Total Depth _____

PRODUCTION

1st 24 hrs. Nat. _____

1st 24 hrs. after shot _____

Gas _____ Cu. Ft.

Dry Hole _____

Abandoned _____

Date

JUL 20 1925

Scout

Home *Courtesy.*
 Map No. **KANSAS** Sec. 10 Twp. 31 R. 3E

Well No. 4 S.R. SmithBeneckum Trees Company

Contractor

SECTION PLAT

320 Ft. from N. Line

_____ Ft. from S. Line

_____ Ft. from E. Line

990 Ft. from W. Line**COMPLETED**

		0	

Location _____

Rig up _____

Drilling and Remarks:

T.S. 3041B.S. 3056T.D. 3058Shot 25 gts.758 ft**RECORD**

Cased _____ in., _____ ft.

Sand _____

Gas _____

Oil _____

Total Depth _____

PRODUCTION

1st 24 hrs. Nat. _____

1st 24 hrs. after shot _____

Gas _____ Cu. Ft.

Dry Hole _____

Abandoned _____

Date

FEB 3 1926S. J. LEWIS

Scout