



Map No. Kansas Sec. 10 Twp. 31 R. 3E


Well No. 5 S. R. Smith Farm  
Bendum + Truss Company

990 Ft. from N. Line

..... Ft. from S. Line

..... Ft. from E. Line

990 Ft. from W. Line

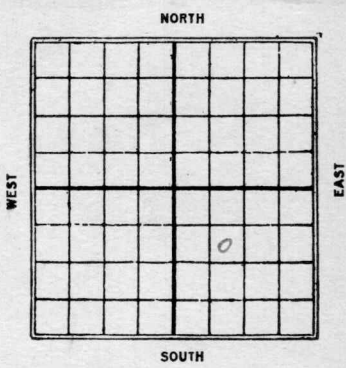

1926

Date	REPORT
------	--------

<u>2/3</u>	<u>Location</u>
<u>3/5</u>	.....
<u>4/7</u>	.....

<u>5/26</u>	<u>&amp; 3018 B.S. 3024.</u> <u>J.D. 3034 Swabbed</u> <u>35 Oil natural. 20f</u> <u>35 Oil.</u>
-------------	--

<u>9-8</u>	<u>Tap Sand 3040-3050'</u> <u>shot 30 qts.</u> <u>25 flo.</u>
------------	---

Map No. *30* **KANSAS** Sec. *10* Twp. *31* R. *3E*

Well No. *5 S R Smith*

*Benedum Trees* Company

Contractor

SECTION PLAT


*990* Ft. from N. Line

----- Ft. from S. Line

----- Ft. from E. Line

*990* Ft. from W. Line

FIRST REPORTS

Location -----

Rig up -----

Drilling and Remarks:

*Location*

RECORD

Cased ----- in., ----- ft.

Sand -----

Gas -----

Oil -----

Total Depth -----

PRODUCTION

1st 24 hrs. Nat. -----

1st 24 hrs. after shot -----

Gas ----- Cu. Ft.

Dry Hole -----

Abandoned -----

Date

FEB 3 1926

S. J. LEWIS

Scout

K1 **KANSAS** Map No. \_\_\_\_\_ Sec. 10 Twp. 31 R. 3E

Well No. 5 S. R. Smith

Benedum Trees Company

Contractor

SECTION PLAT

990 Ft. from N. Line

\_\_\_\_\_ Ft. from S. Line

\_\_\_\_\_ Ft. from E. Line

990 Ft. from W. Line

		0	

FIRST REPORTS

Location \_\_\_\_\_

Rig up \_\_\_\_\_

Drilling and Remarks:

Rig

RECORD

Cased \_\_\_\_\_ in., \_\_\_\_\_ ft.

Sand \_\_\_\_\_

Gas \_\_\_\_\_

Oil \_\_\_\_\_

Total Depth \_\_\_\_\_

PRODUCTION

1st 24 hrs. Nat. \_\_\_\_\_

1st 24 hrs. after shot \_\_\_\_\_

Gas \_\_\_\_\_ Cu. Ft.

Dry Hole \_\_\_\_\_

Abandoned \_\_\_\_\_

Date

Feb 9 1926

S. J. LEWIS

Scout

Map No. **KANSAS** Sec. 10 Twp. 31 R. 3E

Well No. 5 S R Smith

Benedum Trees Company

Contractor

**SECTION PLAT**

990 Ft. from N. Line

----- Ft. from S. Line

----- Ft. from E. Line

990 Ft. from W. Line

		0	

**COMPLETED**

Location -----

Rig up -----

Drilling and Remarks:

*T.S. 3040*  
*T.D. 3050*  
*Prod. 30gts*  
*25886*

**RECORD**

Cased ----- in., ----- ft.

Sand -----

Gas -----

Oil -----

Total Depth -----

**PRODUCTION**

1st 24 hrs. Nat. -----

1st 24 hrs. after shot -----

Gas ----- Cu. Ft.

Dry Hole -----

Abandoned -----

Date

**APR 28 1926**

**S. J. LEWIS**

**192**

Scout

**KANSAS**

Map No. \_\_\_\_\_ Sec. 10 Twp. 31 R. 35

Well No. 5 S R Smith

Beneckman Trees Company

Contractor

**SECTION PLAT**

990 Ft. from N. Line

\_\_\_\_\_ Ft. from S. Line

\_\_\_\_\_ Ft. from E. Line

990 Ft. from W. Line


**COMPLETED**

Location \_\_\_\_\_

Rig up \_\_\_\_\_

Drilling and Remarks:

T.S. 3040

T.D. 3050

8108 30 gts

25 8/16

**RECORD**

Cased \_\_\_\_\_ in., \_\_\_\_\_ ft.

Sand \_\_\_\_\_

Gas \_\_\_\_\_

Oil \_\_\_\_\_

Total Depth \_\_\_\_\_

**PRODUCTION**

1st 24 hrs. Nat. \_\_\_\_\_

1st 24 hrs. after shot \_\_\_\_\_

Gas \_\_\_\_\_ Cu. Ft.

Dry Hole \_\_\_\_\_

Abandoned \_\_\_\_\_

Date

SEP 8 1926

S. J. LEWIS

Scout