


KANSAS

Barton

Section 20 Township 20 Range 12-W

Well No. #1 Batchman

Company ElReco

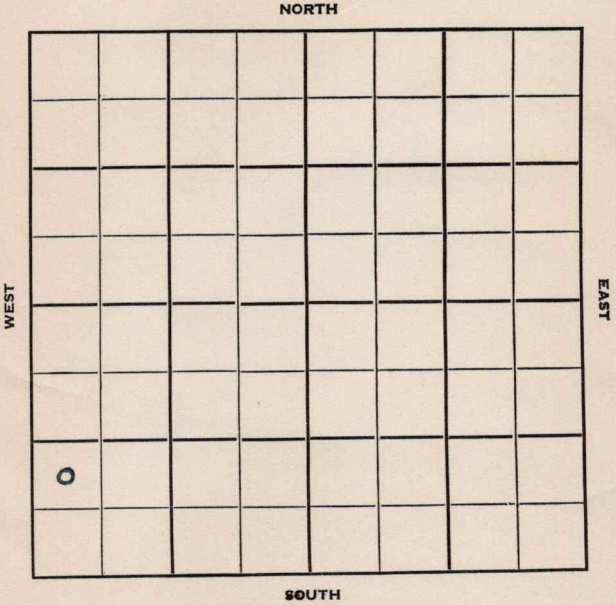

Barton

KANSAS

Sec. 20 Twp. 20 R. 12W

Well No. #1 Batchman Farm

El Reco Company

Anschutz Drlg. - Contr. Contractor
Batchman Pool


 Ft. from N. Line

990' Ft. from S. Line

 Ft. from E. Line

330' Ft. from W. Line

NW SW SW

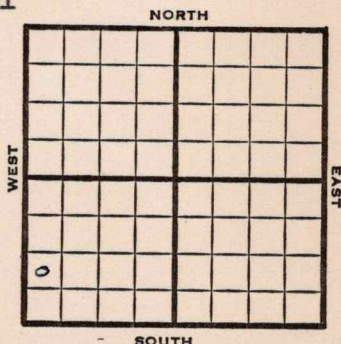

1950

Elev. 1849' REPORT

11/8

Location

11/29

Spud 11-6-50

D&A TD 3484

8-5/8" @ 250

Anhy 655 Heeb. 3062

Br Lime 3181 Lans. 3192

Cong. 3422 Simp sh 3454

Arb. 3466-70

5" @ 3468 SO 3472-84 TD

28/3474-84 TD

D&A **ABANDONED**

County Barton State KansasSec. 20 (Blk. Twp.) 20 (Sur. Rge.) 12W Map No.Operator ElRecoWell No. 1 Farm BatchmanElev. Location NW SW SW

990 Ft. From S Line SW330 Ft. From W Line Quarter1st. Report NOV 8 1950

Completion

Remarks

Anschutz Drlg. - Contr.

Spudding Date

Drlg. Data Batchman PoolLocation

County Barton State KansasSec. 20 (Blk.
Twp.) 20 (Sur.
Rge.) 12W Map No.Operator ElrecoWell No. 1 Farm BatchmanElev. 1849 Location NW SW SW990 Ft. From S Line SW330 Ft. From W Line Quarter1st. ReportCompletion NOV 29 1950Remarks Batchman PoolAnschutz Drlg. - Contr.Spudding Date 11-6-50Drlg. Data D & A TD 34848 5/8" @ 250 Anhy 655 Heeb. 3062Br. lime 3181 Lans. 3192 Cong. 3422Simp. sh. 3454 Arb. 3466-70 5" @ 3468So 3472-84 TD 28/ 3474-84 TDD & A

J. E. TYRA