


Map No. Kansas Sec. 11 Twp. 31 R. 3

Well No. 3 Clark Farm

Ark Fuel Company

NORTH

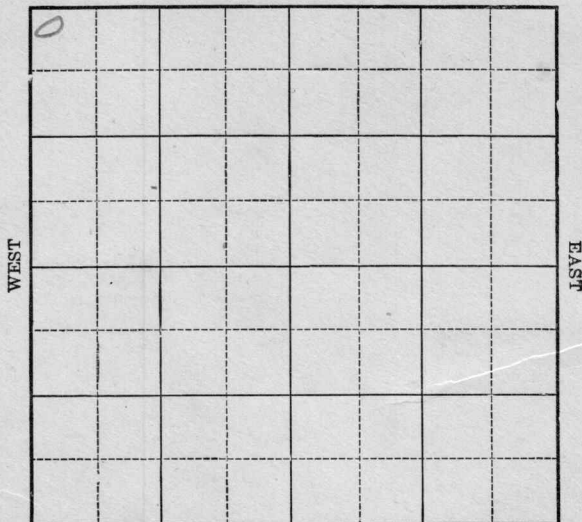

SOUTH

Location \_\_\_\_\_

Drilling Remarks \_\_\_\_\_

Rig Up \_\_\_\_\_

Drilling Remarks \_\_\_\_\_

RECORD

Cased \_\_\_\_\_ in. \_\_\_\_\_ ft.

Sand \_\_\_\_\_

Gas \_\_\_\_\_

Oil \_\_\_\_\_

Total Depth \_\_\_\_\_

PRODUCTION

1st 24 hrs. Nat. \_\_\_\_\_

1st. 24 hrs. after shot \_\_\_\_\_

Gas \_\_\_\_\_ cu. ft.


Dry Hole \_\_\_\_\_

Abandoned \_\_\_\_\_

Map No. Kaw Sec. 11 Twp. 31 R. 3

Well No. 3 Clark Farm \_\_\_\_\_  
Ark. Fuel & Gas Co. Company

300 Ft. from N. Line  
 \_\_\_\_\_ Ft. from S. Line  
 \_\_\_\_\_ Ft. from E. Line  
300 Ft. from W. Line

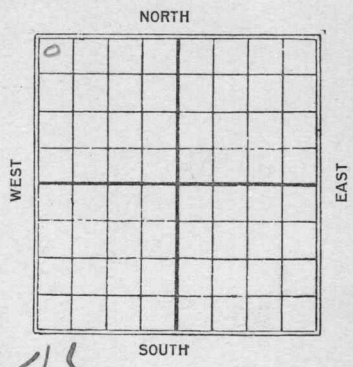

{OWDD}

REPORT

Date	
1925	
<del>6/10</del> 6/5	R.O.G.
7/5	Rig
7/22	Spud + S.D.
7/29	_____
8/17	Spudding'
8/14	1120'
8/19	set 10" - 1610'
8/27	Repair Rig I.D. 1780'
9/2	1810'
9/9	1910' S.D.
9/16	22210'
9/24	2475 - S.W.
9/30	Rig 2585
10/6	2710
10/21	S.G.A. 3040
11/4	S.R. {OWDD} Sly deeper
11/25	Abandoned 2500

**KANSAS**

Map No. \_\_\_\_\_ Sec. 11 Twp. 31 R. 3

Well No. 30 (Lark)

Prk Fuel Company

Contractor \_\_\_\_\_

**FIRST REPORT**

**SECTION PLAT**

300 Ft. from N. Line

\_\_\_\_\_ Ft. from S. Line

\_\_\_\_\_ Ft. from E. Line

300 Ft. from W. Line

6			

Location \_\_\_\_\_

Rig up \_\_\_\_\_

Drilling and Remarks:

*R.O.G.*

**RECORD**

Cased \_\_\_\_\_ in., \_\_\_\_\_ ft.

Sand \_\_\_\_\_

Gas \_\_\_\_\_

Oil \_\_\_\_\_

Total Depth \_\_\_\_\_

**PRODUCTION**

1st 24 hrs. Nat. \_\_\_\_\_

1st 24 hrs. after shot \_\_\_\_\_

Gas \_\_\_\_\_ Cu. Ft.

Dry Hole \_\_\_\_\_

Abandoned \_\_\_\_\_

Date \_\_\_\_\_

**M. A. BENEAR**

**MAY 5 1925**

Scout

KI *County*  
Map No. **KANSAS** Sec. *11* Twp. *31* R. *3E*

Well No. *3 Clark*

*Ark Fuel* Company

Contractor

SECTION PLAT

*300* Ft. from N. Line

\_\_\_\_\_ Ft. from S. Line

\_\_\_\_\_ Ft. from E. Line

*300* Ft. from W. Line

**ABANDONED**

0			

Location \_\_\_\_\_

Rig up \_\_\_\_\_

Drilling and Remarks:

*Sand 2972-2977*

*T 3040*

*Top line @ 3000*

*J & A.*

RECORD

Cased \_\_\_\_\_ in., \_\_\_\_\_ ft.

Sand \_\_\_\_\_

Gas \_\_\_\_\_

Oil \_\_\_\_\_

Total Depth \_\_\_\_\_

PRODUCTION

1st 24 hrs. Nat. \_\_\_\_\_

1st 24 hrs. after shot \_\_\_\_\_

Gas \_\_\_\_\_ Cu. Ft.

Dry Hole \_\_\_\_\_

Abandoned *3040'*

Date

OCT 21 1925  
\_\_\_\_\_ 192\_\_\_\_\_

S. J. LEWIS

Scout

Butler

MAP No. KANSAS SEC. 11 TWP. 31S R. 2E

WELL No. 3 Clark  
Ork. Fuel COMPANY

CONTRACTOR

SECTION PLAT

0			

ABANDONED

\_\_\_\_\_ FT. FROM N. LINE

\_\_\_\_\_ FT. FROM S. LINE

\_\_\_\_\_ FT. FROM E. LINE

\_\_\_\_\_ FT. FROM W. LINE

19K

RECORD

LOCATION \_\_\_\_\_

CASED \_\_\_\_\_ IN., \_\_\_\_\_ FT.

RIG UP \_\_\_\_\_

SAND \_\_\_\_\_

DRILLING AND REMARKS:

GAS \_\_\_\_\_

SS 2972-77

OIL \_\_\_\_\_

TOTAL DEPTH 3040

Soil.  
Dry Miss limo  
3000

PRODUCTION

1ST 24 HRS. NAT. \_\_\_\_\_

1ST 24 HRS. AFTER SHOT \_\_\_\_\_

GAS \_\_\_\_\_ CU. FT.

DRY HOLE

ABANDONED

DATE

10/22 5

192

SCOUT

✓

Map No. *ANSAS* Sec. *11* Twp. *21* R. *3E*

Well No. *#3 Clark*

*Per Fuel* Company

Contractor

*{O.W.D.D.}*

SECTION PLAT

*300* Ft. from N. Line

\_\_\_\_\_ Ft. from S. Line

\_\_\_\_\_ Ft. from E. Line

*300* Ft. from W. Line

<i>0</i>			

*Correction.*

Location \_\_\_\_\_

Rig up \_\_\_\_\_

Drilling and Remarks:

*W 3040*

*Str. Reaming  
They abandoned  
this well and  
now have decided  
to drill deeper*

RECORD

Cased \_\_\_\_\_ in., \_\_\_\_\_ ft.

Sand \_\_\_\_\_

Gas \_\_\_\_\_

Oil \_\_\_\_\_

Total Depth \_\_\_\_\_

PRODUCTION

1st 24 hrs. Nat. \_\_\_\_\_

1st 24 hrs. after shot \_\_\_\_\_

Gas \_\_\_\_\_ Cu. Ft.

Dry Hole \_\_\_\_\_

Abandoned \_\_\_\_\_

Date

NOV 4 1925 192

S. J. LEWIS

Scout

*K1 Cowley*  
Map No. **KANSAS** Sec. *11* Twp. *31* R. *31*

Well No. *3 Clark*

*Rock Fuel* Company

Contractor

SECTION PLAT

*300* Ft. from N. Line

\_\_\_\_\_ Ft. from S. Line

\_\_\_\_\_ Ft. from E. Line

*300* Ft. from W. Line

0			

**ABANDONED**

*check other completion*

Location \_\_\_\_\_

Rig up \_\_\_\_\_

Drilling and Remarks:

*T.D 3500*

*D & A.*

RECORD

Cased \_\_\_\_\_ in., \_\_\_\_\_ ft.

Sand \_\_\_\_\_

Gas \_\_\_\_\_

Oil \_\_\_\_\_

Total Depth \_\_\_\_\_

PRODUCTION

1st 24 hrs. Nat. \_\_\_\_\_

1st 24 hrs. after shot \_\_\_\_\_

Gas \_\_\_\_\_ Cu. Ft.

Dry Hole \_\_\_\_\_

Abandoned \_\_\_\_\_

Date

NOV 25 1925

192

S. J. LEWIS

Scout