


Section 12 Township 31 Range 3E

Well No. 2 DeWitt

Company B.B. B. air (Tulsa)

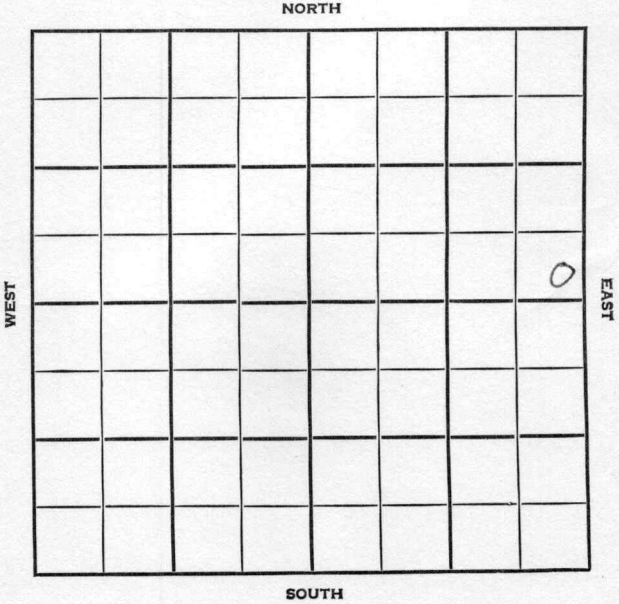

KANSAS

SEC. Cowley  
 12

TWP. 31

R. 3E

WELL NO. #2 DeWitt

FARM

COMPANY B. B. Blair (Tulsa)


CONTRACTOR McKanb & Lindsay

Clark Ext. \_\_\_\_\_ Ft. from N. Line

\_\_\_\_\_ Ft. from S. Line

\_\_\_\_\_ Ft. from E. Line

\_\_\_\_\_ Ft. from W. Line

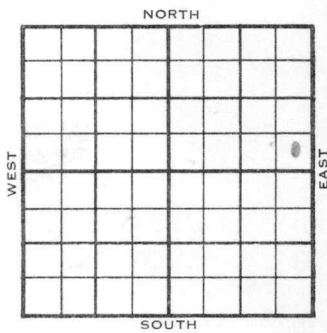

SE SE NE

|      | ELEVATION   | REPORT    |
|------|---|-----------|
| 1955 | 1149'   |           |
| 7/20 | Comm 7-2-55<br>8" @ 105/85 cored 2865-2900, "ec. 35'<br>Bart. sd, 2872 TD 2900, 5½" @2874<br>V. Bart. 2872, TD 2900                               |           |
| 8/10 | TD 2900 5½" @2874 CO to 2900 frac F/<br>112 bo 24 hr. Comp: 25 bopd: KC: 2341,<br>1192; BKC: Oswego 2656, 1507; S. Bart:<br>2872, 1723; TD: 2900. |           |
|      |   | COMPLETED |

|               |        |           |          |  |
|---------------|--------|-----------|----------|--|
| Date Comm.    | 7-2-55 |           |          |  |
| 8" @ 105/85   | Cored  | 2865-2900 | Rec.     |  |
| 35' Bart. sd. | 2872   | TD 2900   | 5 1/2" @ |  |
| 2874          |        |           |          |  |

County Cowley Elev. 1149 Co. 1  
 Sec. 12 Twp. 31 Rge. 3E  
 Company B. B. Blair (Tulsa)  
 Farm Name DeWitt No. 2

| TOPS                 | DEPTH       | LOG | DATUM       |
|----------------------|-------------|-----|-------------|
| Anh.                 |             |     |             |
| T.P.                 |             |     |             |
| H.                   |             |     |             |
| Tr.                  |             |     |             |
| Dg.                  |             |     |             |
| BL.                  |             |     |             |
| L.                   |             |     |             |
| K.C.                 | <u>2341</u> |     | <u>1192</u> |
| B.K.C. <u>Cowley</u> | <u>2656</u> |     | <u>1507</u> |
| Ce.                  |             |     |             |
| C.                   |             |     |             |
| M.                   |             |     |             |
| M.                   |             |     |             |
| K.                   |             |     |             |
| Mz.                  |             |     |             |
| Mq.                  |             |     |             |
| V.                   |             |     |             |
| S. <u>Bart</u>       | <u>2872</u> |     | <u>1723</u> |
| S.                   |             |     |             |
| A.                   |             |     |             |
| R.                   |             |     |             |
| Pe.                  |             |     |             |
| G.                   |             |     |             |
| TD.                  | <u>2900</u> |     |             |

Loc. in Sec.

SE SE NE

Geol.

Contr.

McKnab &amp; Lind

Pool

Clark Ext.

Date Comm. 7-2-55

AUG 1 0 1955

8" @ 105/85 cred 2865-2900 rec.

35' bart. sd. TD 2900 5 1/2" @ 2874

CO to 2900 frac P/ 112 bo 24 hr.

Comp. 25 bopd