

KANSAS

Cowley

SECTION 12 TOWNSHIP 31 RANGE 3 E

WELL NO. #2 Olson

COMPANY Stelbar

NORTH

						0	

WEST

EAST

SOUTH

Cowley

KANSAS


SEC. 12	TWP. 31	R. 3E
------------	------------	----------

WELL NO. #2 Olson FARM

COMPANY Stelbar

CONTRACTOR Co. tools

800 Ft. from N. Line
 Ft. from S. Line
 700 Ft. from E. Line
 Ft. from W. Line

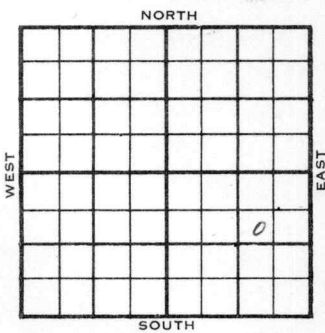

SW NE SE

	ELEVATION	REPORT
--	-----------	--------

1956	1143'	
1-5	## MIR	
1-18	Comm. 1-5-56 8 5/8" @ 100/78 Cored 2860-82 1/2, full rec. D & A KC 2315 Bart 2858 M. 2909 TD 2968'	

ABANDONED

County Cowley Elev. _____
 Sec. 12 Twp. 31 Rge. 3E
 Company Stelbar
 FarmName Olson No. 2

TOPS	DEPTH	LOG	DATUM	Loc. in Sec.
Anh.				SW NE SE
Tp.				800' NL
H.				700' EL
Tr.				
Dg.				
Bl.				
L.				Geol.
K.C.				Contr.
B.K.C.				Co. tools
Ce.				
C.				Pool
M.				Clark
M.				
K.				
Mz.				
Me.				
V.				
S.				
S.				
A.				
R.				
Pe.				
G.				
T.D.				

FIRST REPORT
 JAN 5 '56

Date Comm.

M I R

Co.

Lse.

No.

Sec.

T.

R.

County Cowley Elev. 1143 Co. Co.
 Sec. 12 Twp. 31 Rge. 3E
 Company Stelbar
 Farm Name Olson No. 2

TOPS	DEPTH	LOG	DATUM	Loc. in Sec.
Anh.				SW NE SE
Tp.				800' NL
H.				700' EL
Tr.				
Dg.				
Bl.				
L.				
K.C.	<u>2315</u>		<u>1172</u>	Geol.
B.K.C.	<u>Bart 2858</u>		<u>1715</u>	Contr.
Ce.				Co. tools
C.				
M.	<u>2909</u>		<u>1766</u>	Pool
M.				Clark
K.				
Mz.				
Ma.				
V.				
S.				
S.				
A				
R.				
PE.				
G.				
ED.	<u>2968</u>			



Date Comm. 1-5-56 JAN 1 8 1956

8 5/8" @ 100/78 Cored 2860-82 1/2

full rec.

D & A

Co.
Lse.
No.
Sec.
T.
R.