


Section 12 Township 31 Range 3E

Well No. #6 Olson

Company Stelbar

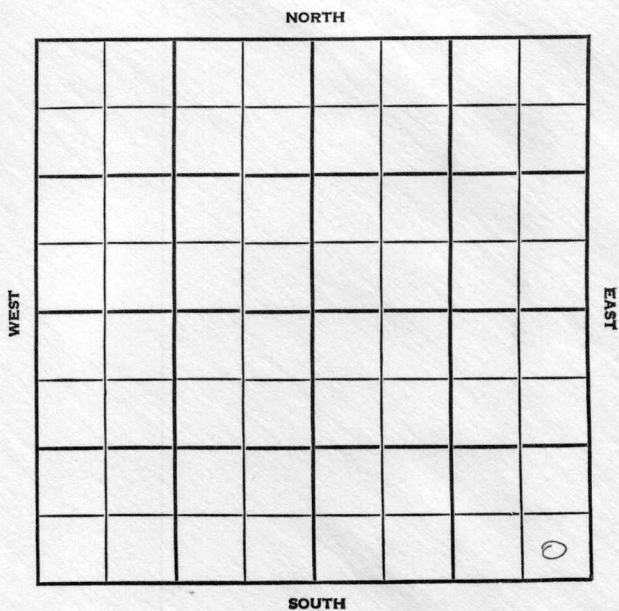

Cowley

KANSAS

SEC. 12

TWP. 31

R. 3E

WELL NO. #6 Olson FARM

COMPANY Stelbar

CONTRACTOR Prairie

Clark


FT. FROM N. LINE

FT. FROM S. LINE

FT. FROM E. LINE

FT. FROM W. LINE

SE SE SE

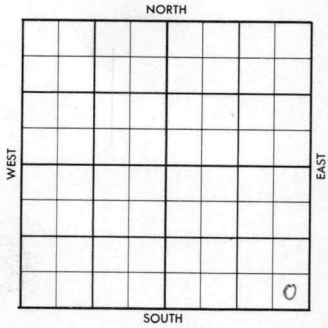

	ELEVATION	REPORT
1956	1148'	

6-6 Comm. 6-3-56  
 8" @ 125  
 Drlg. 1006

8-1 5" @ 2872 w/50  
 P/ 50 bopd,  
 P/ 25 BOPD, no/wtr.,  
 # Bv. Z. 2860'; Bv. sd. 2870';  
 TD 2895'

COMPLETED

County Cowley Elev. \_\_\_\_\_  
 Sec. 12 Twp. 31 Rge. 3E  
 Company Stelbar  
 FarmName Olson No. 6

TOPS	DEPTH	LOG	DATUM
Anh.			
Tp.			
H.			
Tr.			
Dg.			
Bl.			
L.			
K.C.			
B.K.C.			
Ce.			
C.			
M.			
M.			
K.			
Mz.			
Mo.			
V.			
S.			
S.			
A.			
R.			
PE.			
G.			
T.D.			

Loc. in Sec. SE SE SE  
 Geol. \_\_\_\_\_  
 Contr. Prairie  
 Pool Clark

FIRST REPORT  
 JUN 6 1956

Date Comm. 6-3-56  
8" @ 125 d rlg. 1006

JUN 1 1956

R.C.

219

Co.  
 Lse.  
 No.  
 Sec.  
 T.  
 R.

County Cowley Elev. 1148  
 Sec. 12 Twp. 31 Rge. 3E  
 Company Steiblar  
 Farm Name Olson No. 6

TOPS	DEPTH	LOG	DATUM	Loc. in Sec.
Anh.				SE SE SE
Tp.				
H.				
Tr.				
Dg.				
Bl.				
L.				Geol.
K.C.				
B.K.C.				Contr.
Ce. <u>Bv Z</u>	<u>2860</u>			<u>Prairie</u>
C. <u>Bv sd</u>	<u>2870</u>			
M.				Pool
M.				<u>Clark</u>
K.				
Mz.				
Me.				
V.				
S.				
S.				
A.				COMPLETE
R.				
PE.				
G.				
T.D.	<u>2895</u>			

Date Comm. 6-3-56 AUG 1 1956

8" @ 125 drls. 1006 JUN 13 '56

5" 2872/50 SY JUN 20 '56 WOCT JUN 27 '56

JUL 3 '56 JUL 11 '56 MICT JUL 18 '56 CO 2885

Frac Pap JUL 25 '56 AUG 1 '56 P. 50

Boyd P. 25 Boyd no/wt

Co.  
Lse.  
No.  
Sec.  
T.  
R.