DX 78-1 Barton KANSAS

Section 20 Township 20 Range 12 W

Well No. #2 Barchman (Batchman)

Company Rocket Drlg.

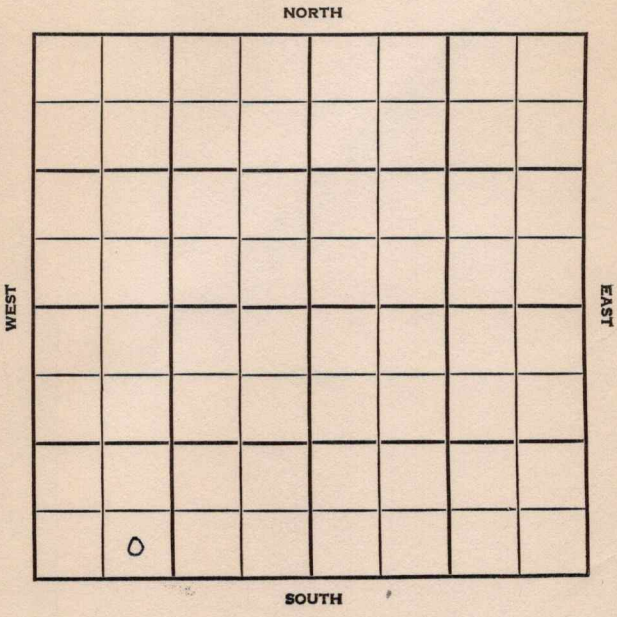

Barton KANSAS

SEC.	TWP.	R.
20	20	12W

WELL NO.
#2 Batchamn FARM

COMPANY
Rocket Drlg.

CONTRACTOR
Co. Tools

Batchman

_____ Ft. from N. Line

_____ Ft. from S. Line

_____ Ft. from E. Line

_____ Ft. from W. Line

SE SW SW

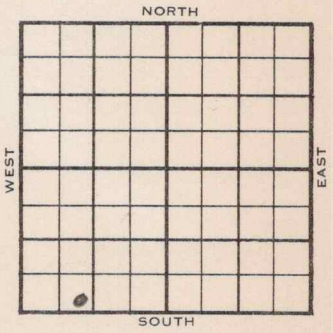

1955 ELEVATION 1859' REPORT

8/3
9-7

Loeation

FIRST REPORT

Comm. 8-18-55
8 5/8" @ 227/200
DST 3196-3236, open 1 hr., rec.205' gcmw 1095#
DST 3347-84, open 1 hr., rec.160' msw 1160#
DST 3455-73, open 1 hr., rec.16' mud 0#
DST 3496-96, open 1 hr., rec. 35' socm 0#
DST 3496-3509, open 1 hr., rec. 20' socm
DST 3473-86, open 1 hr., rec. 30' mud 0#
D & A

TOPS:	DEPTH
H.	3069
B.L.	3191
L.	3207
A	3453

T.D. 3533'

ABANDONED

DX-78

FORM 513 REV. SUNRAY

County Barton Elev.

Sec. 20 Twp. 20 Rge. 12W

Company Rocket Drlg.

Farm Name Batchman No. 2

TOPS	DEPTH	LOG	DATUM
Anh.			
Tp.			
H.			
Tr.			
Dg.			
B.L.			
L.			
K.C.			
B.K.C.			
Ce.			
C.			
M.			
M.			
K.			
Mz.			
Mq.			
V.			
S.			
S.			
A			
R.			
P€.			
G.			
T.D.			

Loc. in Sec. SE SW SW

Geol.

Contr. Co. tools

Pool Batchman

FIRST REPORT

AUG 3 '55

Date Comm.

Location

Co. Lse. No. Sec. T. R.

FORM 513 REV. SUNRAY

County Barton Elev. 1859

Sec. 20 Twp. 20 Rge. 12W

Company Rocket Drlg.

Farm Name Batchman No. 2

TOPS	DEPTH	LOG	DATUM
Anh.			
Tp.			
H.	3069		1210
Tr.			
Dg.			
B.L.	3191		1332
L.	3207		1348
K.C.			
B.K.C.			
Ce.			
C.			
M.			
M.			
K.			
Mz.			
Mo.			
V.			
S.			
S.			
A	3453		1594
R.			
P€.			
G.			
T.D.	3533		

Loc. in Sec. SE SW SW

Geol.

Contr. Co. tools

Pool Batchman

ABANDONED

SEP 7 1955

Date Comm. 8-18-55

8 5/8" @ 227/200 DST 3196-3236 open 1 hr. Rec. 205' gcmw 1095# DST 3347-84 open 1 hr. Rec. 160' msw 1160# DST 3455-73 open 1 hr. Rec. 16' mud 0# DST 3496-96 open 1 hr. Rec. 35' socm 0# DST 3496-3509 open 1 hr. Rec. 20' socm DST 3473-86

OVER

Co. Lse. No. Sec. T. R.

open 1 hr. Rec. 30' mud 0#

D & A

Scout Cards
Land Small Map
Land Wall Map
Tracings
France Map
Pierce Map
Misc.

SEP 15 1955

11874L