


Section 13 Township 31 Range 3E

Well No. #2 G. E. Frier

Company Stelbar Oil Corp.

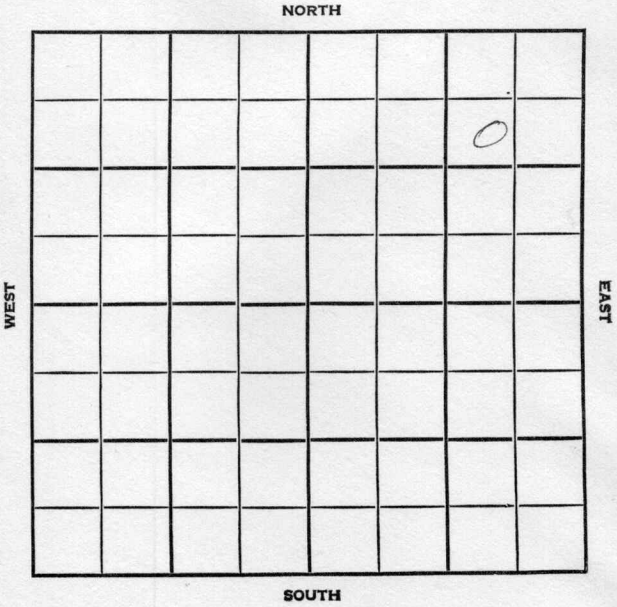

County Cowley Elev. 1146
 Sec. 13 Twp. 31 Rge. 3E
 Company Stelbar Oil Corp.
 Farm Name G. E. Frier No. 2

TOPS	DEPTH	LOG	DATUM	Loc. in Sec.
Anh.				SW NE NE
TP.				960' fnl, 740'
H.				
Tr.				
Dg.				
Bl.				fel NE/4
L.				Geol.
K.C.	2330			Contr.
B.K.C.				
Ce.				
C.				Prairie Oil & Gas Tools
M.				Pool
M.				
K.				Clark
Mz.				SEP 26 '56
Me.				
V.				
S.				
S.				
A.				
R.				
Pe.				
G.				
T.D.	2886			FIRST REPORT

Date Commspd 9-3-56

COMPLETED

8" @125 w/125, Btvl sd 2867 $\frac{1}{2}$ -83, Btvl sh 2883-86, Btvl Sec. was Cored, Interval not available, 5" @ 2867 $\frac{1}{2}$ w/80, CO2883, Fu 700' oil NW, 12 hrs. Frac 3+3, swb Ld, flw 110, BO nw, NT died, POP P 50 BOPD & nw, Complete for 25 BOPD, Btvl 2867 $\frac{1}{2}$ -83, PBTD 2883

29

County Cowley Elev. 1146
 Sec. 13 Twp. 31 Rge. 3E
 Company Stelbar Oil Corp.
 Farm Name C. E. Frier No. 2

TOPS	DEPTH	LOG	DATUM	Loc. in Sec.
Anh.				SW NE NE
Tp.				960' fnl, 740'
H.				fel NE/4
Tr.				Geol.
Dg.				Contr.
Bl.				Prairie Oil
L.				Gas Tools
K.C.	2330			Pool
B.K.C.				Clark
Ce.				
C.				
M.				
M.				
K.				
Mz.				
Me.				
V.				
S.				
S.				
A.				
R.				
Pe.				
G.				
T.D.	2886			

OCT	3	'55
COMPLETE		

Date Comm. spd 9-3-56

8" @ 125 w/125, Btvl Sd 2867 $\frac{1}{2}$ -83, Btvl sh
 2883-86, Btvl Sec. was Cored, Interval not
 available, 5" @ 2867 $\frac{1}{2}$ w/80, CO2883, Fu 700'
 oil NW, 12 hrs. Frac 3+3, swb Ld, Flw 110,
 BO nw, NT died, POP P 50 BOPD & nw, Complete
 for 25 BOPD, Btvl 2867 $\frac{1}{2}$ -83, PBD 2883