


Map No. K Sec. 13 Twp. 31 R. 3

Well No. 1 - Supter Farm
Alcorn Company

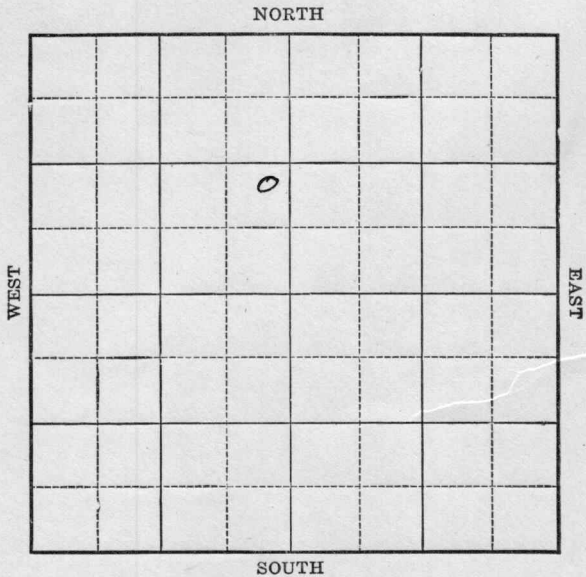

Location _____

Drilling Remarks:

RECORD

Cased _____ in. _____ ft.

Sand _____

Gas _____

Oil _____

Total Depth _____

Rig Up _____

Drilling Remarks:

PRODUCTION

1st 24 hrs. Nat. _____

1st 24 hrs. after shot _____

Gas _____ cu. ft.

Dry Hole _____

Abandoned _____

Map No. **KANSAS** 1 Sec. 13 Twp. 31 R. 3

Well No. 1 Lupton

Alcorn Company

Contractor

1/2 sec 12 all sec - 13

SECTION PLAT

FIRST REPORT

		o	

----- Ft. from N. Line

1020 Ft. from S. Line

300 Ft. from E. Line

----- Ft. from W. Line

Location -----

Rig up -----

Drilling and Remarks:

Timbers

RECORD

Cased ----- in., ----- ft.

Sand -----

Gas -----

Oil -----

Total Depth -----

PRODUCTION

1st 24 hrs. Nat. -----

1st 24 hrs. after shot -----

Gas ----- Cu. Ft.

Dry Hole -----

Abandoned -----

Date

FEB 4 1924

M. A. BENEAR

192-----

Scout

(Over)

my map shows
Casden O. & G. has
130 A. in N 1/2 Sec
23-31-3

Handwritten signature

EF from W. line
EF from E. line
EF from S. line
EF from N. line

SEC. 31-3
Contract
Company
Date
No.
Page

Butler

K1 KANSAS MAP NO. SEC. 13 TWP. 31S R. 3E

WELL NO. 1 Leptem
Alcorn COMPANY

CONTRACTOR

ABANDONED

SECTION PLAT

	0		

_____ FT. FROM N. LINE
_____ FT. FROM S. LINE
_____ FT. FROM E. LINE
_____ FT. FROM W. LINE

OK

RECORD

LOCATION _____

CASED _____ IN., _____ FT.

RIG UP _____

SAND _____

DRILLING AND REMARKS:

GAS _____

2977 2 1/2 hrs
lost hole

OIL _____

TOTAL DEPTH 310 1/2

PRODUCTION

1ST 24 HRS. NAT. _____

1ST 24 HRS. AFTER SHOT _____

GAS _____ CU. FT.

DRY HOLE

ABANDONED

DATE

5/19

192

SCOUT

Map No. **KANSAS** Sec. 13 Twp. 31 R. 3

Well No. 1 Tap

Plowman Company

Contractor

ABANDONED

SECTION PLAT

----- Ft. from N. Line

1620 Ft. from S. Line

360 Ft. from E. Line

----- Ft. from W. Line

	0		

Location -----

Rig up -----

Drilling and Remarks:

Tap L. 2977
L & A 3100

RECORD

Cased ----- in., ----- ft.

Sand -----

Gas -----

Oil -----

Total Depth -----

PRODUCTION

1st 24 hrs. Nat. -----

1st 24 hrs. after shot -----

Gas ----- Cu. Ft.

Dry Hole -----

Abandoned -----

Date

M. A. BENEAR

MAY 22 1924

192

Scout