

Butler

FORM 51

KANSAS

Section 14 Township 27 Range 7E

Well No. #3 Harris

Company Sunflower Drlg.

NORTH

							o		

SOUTH

WEST

EAST

Butler KANSAS

SEC.	TWP.	R.
14	27	7E ✓

WELL NO. **3 Harris** FARM

COMPANY **Sunflower Drlg.**

CONTRACTOR


**Keighley Pool**

330 Ft. from N. Line

\_\_\_\_\_ Ft. from S. Line

990 Ft. from E. Line

\_\_\_\_\_ Ft. from W. Line

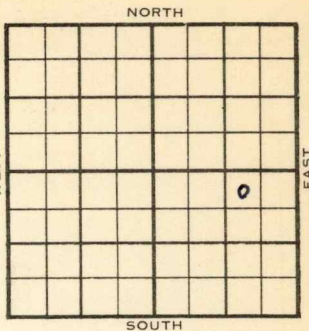

NW NE SE

	ELEVATION	REPORT
1954	<b>1447'</b>	

3/24 **Bart 2628'**  
 TD 2676'  
 5" @ 2650'  
 CO to 2676  
 Sd-frac

4/14 Oil Well  
 TD 2676'  
**Bart 2628'**  
 TD 2676'  
 5" @ 2650'  
 CO to 2676'  
 Sd-frac  
 Comp. 20 bopd

**COMPLETED**



