


FORM 51

Barton

Section 20 Township 20 Range 12W

Well No. #1 Fisher

Company G-M-R Oil

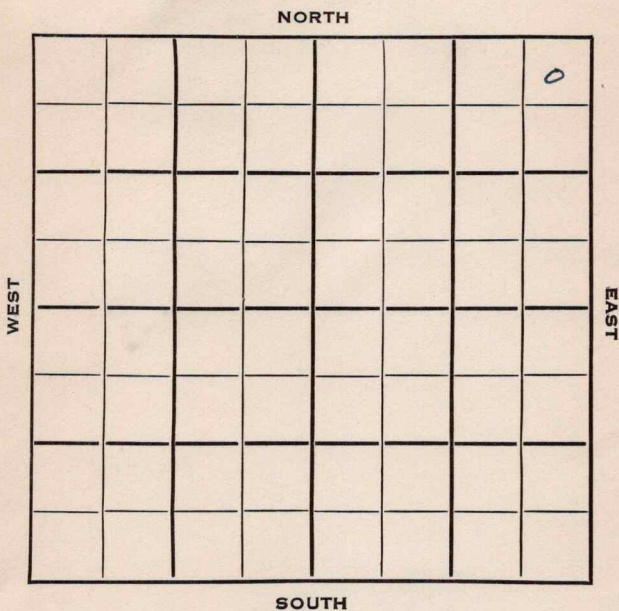

Sec. 20 Twp. 20 R. 12W

Well No. #1 Fisher Farm

G-M-R Oil Company

G-M-R Contractor


330 Ft. from N. Line

Ft. from S. Line

330 Ft. from E. Line

Ft. from W. Line

NE NE NE

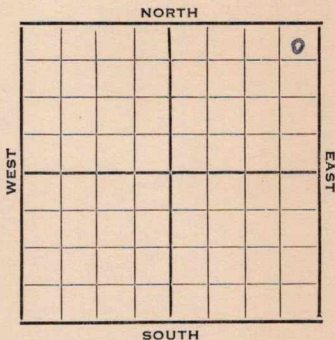

1953 Elev. 1838' REPORT

2/18 Location
2/26 8" @ 205'

3/12 Heeb 3036 Br li 3159 Lans 3174
DST 3215-32, 3/4 hr, 5' M

3/19 Arb. 3421 RTD 3428 5" @ 3423
DD 3435
2 goph
28' of 4" liner @ 3433
CO-3435
5 goph DD 3444, 250A

3 2 5 Spud 2-23-53
D&A
TD 3507
8" @ 205
Heeb 3036, Br lime 3159, Lans 3174
DST 3215-32, opn 3/4 hrs., rec. 5' mud, 0#
Arb. 3421
TD 3428
5" @ 3423
DD 3435 2 goph CO to 3435
5 goph DD 3444 250 A
DD 3453, S/8 boph, DD 3455, 1000A, 1 1/2 goph, DD 3507 HFW
D&A

ABANDONED

County Barton State Kansas

Sec. 20 (Blk.) 20 (Sur. Rge.) 12W Map No.

Operator G-M-R Oil

Well No. 1 Farm Fisher

Elev. 1838 Location NE NE NE

330 Ft. From N Line NE

330 Ft. From E Line Quarter

1st. Report

Completion MAR 25 1953

Remarks Wildcat

G-M-R - Contr.

Spudding Date 2-23-53

ABANDONED

Drlg. Data D & A TD 3507

8" @ 205 Heeb. 3036 Br. lime 3159

Lans. 3174 DST 3215-32 open 3/4 hr.

Rec. 5' mud O# Arb. 3421 TD 3428

5" @ 3423 DD 3435 2 goph CO to 3435

5 goph DD 3444 250 A DD 3453

S/ 8 goph DD 3455 1000 A 1 1/2 boph

DD 3507 HFW

D & A