


Section 17 Township 27 Range 7 E

Well No. # 1 Eckel

Company Eckland Drlg.

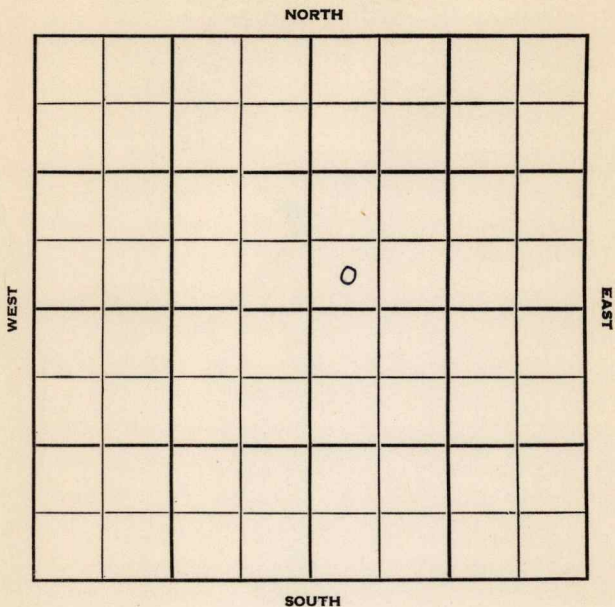

Butler

KANSAS

Sec. 17 Twp. 27 R. 7E ✓

Well No. #1 Eckel Farm

Eckland Drlg. Company

Contractor


Ft. from N. Line

330' Ft. from S. Line

Ft. from E. Line

330' Ft. from W. Line

SW SW NE

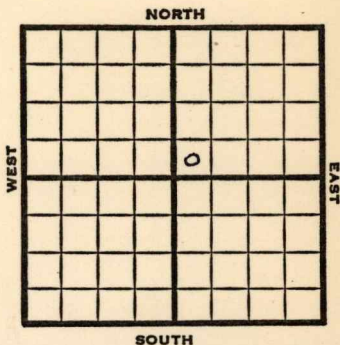

1951

Elev. 1399' REPORT

4/18 Cellar & Pits

5/23 Spud 4-22-51
D&A TI 2666
8" @ 98

Sand 2610 TD 2666'
DST 2640-56 opn 1 hr.
Rec. 160' mud 240' sw
D&A

ABANDONED

County Butler State Kansas

Sec. 17 (Blk. 27) (Sur. 7E) Map No. 27

Operator Eckland Drlg.

Well No. 1 Farm Eckel

Elev. 1399 Location SW SW NE

ABANDONED

330 Ft. From S Line NE

330 Ft. From W Line Quarter

1st. Report

Completion MAY 23 1951

Remarks

Spudding Date 4-22-51

Drlg. Data D & A TD 2666

8" @ 98 Sand 2610 TD 2666 DST 2640-56

open 1 hr. Rec. 160' mud 240' sw

D & A