

Sawley

Map No. **KANSAS** Sec. *15* Twp. *31* R. *3^E*

Well No. *1-2-1-1* Farm

Shawver et al Company

NORTH

WEST

EAST

			0				

SOUTH

Location.....

Drilling Remarks

.....

.....

Rig Up.....

Drilling Remarks

.....

.....

RECORD

PRODUCTION

Cased..... in..... ft.

Sand.....

Gas.....

Oil.....

Total Depth.....

1st 24 hrs. Nat.....

1st 24 hrs. after shot.....

Gas..... cu. ft.....

Dry Hole.....


Abandoned.....

Pawley

Map No. KANSAS Sec. 15 Twp. 31 R. 3^E

Well No. 1-*Leggett* Farm
Shawver et al Company

330 Ft. from N. Line
 _____ Ft. from S. Line
330 Ft. from E. Line
 _____ Ft. from W. Line

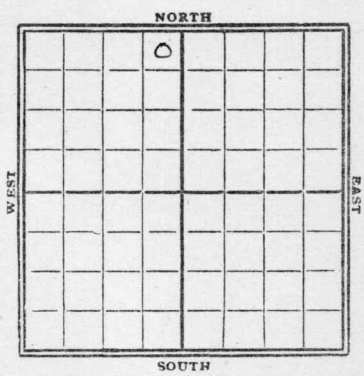

1929

Date	REPORT
<u>1/16</u>	<u><i>Rig</i></u>
<u>1/23</u>	<u>_____</u>
<u>1/30</u>	<u>_____</u>
<u>2/6</u>	<u>_____</u>
<u>2/13</u>	<u>_____</u>
<u>2/20</u>	<u><i>Loc. only</i></u>
<u>2/27</u>	<u>_____</u>
<u>3/6</u>	<u>_____</u>
<u>3/13</u>	<u>_____</u>
<u>3/20</u>	<u>_____</u>
<u>3/27</u>	<u><i>Rig up</i></u>
<u>4/3</u>	<u>_____</u>
<u>4/10</u>	<u><i>Spud 150'</i></u>
<u>4/17</u>	<u><i>Drly 785'</i></u>
<u>4/24</u>	<u><i>" 1730'</i></u>
<u>5/1</u>	<u><i>log 2130'</i></u>
<u>5/8</u>	<u>_____</u>
<u>5/15</u>	<u>_____</u>
<u>5/22</u>	<u>_____</u>
<u>5/29</u>	<u><i>Drly 2350'</i></u>
<u>6/5</u>	<u><i>" 2500'</i></u>
<u>6/12</u>	<u><i>log 2885'</i></u>

6/19- Chat 2982-3006'

36 bbls natural
shot 40 gts - No test

6/26- sand 2982-3006'

T.D. 3006'

shot 40 gts

125 bbls oil

Pump.

Overley
K1 KANSAS

MAP NO. _____ SEC. 15 TWP. 31 R. 3E

WELL NO. 1 Siggett

Shawver et al COMPANY

CONTRACTOR

SECTION PLAT

	0		

330 FT. FROM N. LINE

_____ FT. FROM S. LINE

330 FT. FROM E. LINE

_____ FT. FROM W. LINE

FIRST REPORTS

LOCATION ✓

RIG UP _____

DRILLING AND REMARKS:

RECORD

CASED _____ IN., _____ FT.

SAND _____

GAS _____

OIL _____

TOTAL DEPTH _____

PRODUCTION

1ST 24 HRS. NAT. _____

1ST 24 HRS. AFTER SHOT _____

GAS _____ CU. FT.

DRY HOLE _____

ABANDONED _____

DATE

JAN 16 1929

S. J. LEWIS SCOUT

Cowley

Map No. **KANSAS** Sec. *15* Twp. *31* R. *3*^E

Well No. *1 Higgett*

Shewover et al Company

Contractor

COMPLETE

SECTION PLAT

330 Ft. from N. Line

Ft. from S. Line

330 Ft. from E. Line

Ft. from W. Line

	<i>0</i>		

Location.....

Rig up.....

Drilling and Remarks:

40/175 Bls.

RECORD

Cased..... in., ft.

Sand *2982-3006*

Gas.....

Oil.....

Total Depth *3006*

PRODUCTION

1st 24 hrs. Nat.....

1st 24 hrs. after shot.....

Gas..... Cu. Ft.

Dry Hole.....

Abandoned.....

Date

JUN 26 1929

192

CHAS. L. SHERWOOD

Scout