

Map No. Kan Sec. 15 Twp. 27 R. 7
 Well No. 1 King Farm _____
Derrien & Belliere Company

NORTH

SOUTH

WEST

EAST

Location _____

Drilling Remarks

RECORD

Cased _____ in. _____ ft.

Sand _____

Gas _____

Oil _____

Total Depth _____

Rig Up _____

Drilling Remarks

PRODUCTION

1st 24 hrs. Nat. _____

1st. 24 hrs. after shot _____

Gas _____ cu. ft.

Dry Hole _____

Abandoned _____

Map No. Kan Sec. 15 Twp. 27 R. 7Well No. 1 King Farm
Terrien & Belliere Company


Ft. from N. Line

250 Ft. from S. Line

Ft. from E. Line

250 Ft. from W. Line

NORTH

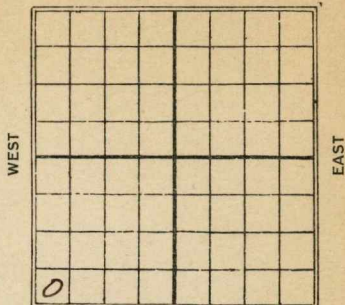

SOUTH

Date

REPORT

19256/26 Location7/3 _____7/10 _____7/17 _____7/24 thru locator7/31 _____

Map No. 10 Sec. 15 Twp. 27 R. 7

Well No. 1 Hing
Jennings & Belliere Company

Contractor

FIRST REPORTS

SECTION PLAT

_____ Ft. from N. Line

250 Ft. from S. Line

_____ Ft. from E. Line

250 Ft. from W. Line

Location _____

Rig up _____

Drilling and Remarks:

RECORD

Cased _____ in., _____ ft.

Sand _____

Gas _____

Oil _____

Total Depth _____

PRODUCTION

1st 24 hrs. Nat. _____

1st 24 hrs. after shot _____

Gas _____ Cu. Ft.

Dry Hole _____

Abandoned _____

Date

JUN 26 1925

CHAS. L. SHERWOOD

192

Scout

Map No. 16 Stark Sec. 15 Twp. 27 R. 7Well No. 1 DingFerris & Bell Company

Contractor

COMPLETED

SECTION PLAT

Ft. from N. Line

250 Ft. from S. Line

Ft. from E. Line

250 Ft. from W. Line

ABANDONED

Location

Rig up

Drilling and Remarks:

RECORD

Cased _____ in., _____ ft.

Sand _____

Gas _____

Oil _____

Total Depth to hole made

PRODUCTION

1st 24 hrs. Nat. _____

1st 24 hrs. after shot _____

Gas _____ Cu. Ft.

Dry Hole _____

Abandoned location

Date

JUL 31 1925

CHAS. L. SHERWOOD

192

Scout