

Map No. _____ Sec. 17 Twp. 27 R. 7
Well No. 1 Knox _____ Farm
Ray _____ Company
Etal

NORTH

0

WEST

EAST

SOUTH

Location _____

Drilling Remarks:

Rig up _____

Drilling Remarks:

RECORD

Cased _____ in. _____ ft.

Sand _____

Gas _____

Oil _____

Total Depth _____

PRODUCTION

1st 24 hrs Nat.

1st 24 hrs. after shot

Gas _____ cu. ft.

Dry Hole_____

Abandoned

Map No. _____ Sec. 17 Twp. 27 R. 7

Well No. 1 Knox Farm _____
Ray Etal Company _____


NORTH

200 Ft. from N. Line

_____ Ft. from S. Line

_____ Ft. from E. Line

200 Ft. from W. Line

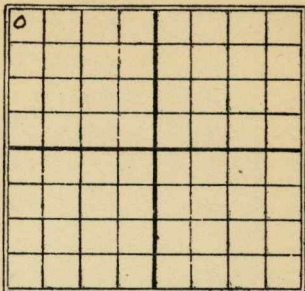

WEST

EAST

SOUTH

Date
1923

REPORT

3/2 Rig.
8/4 S.D. 2750'
10/3 Gas sand 2606-20' - 2 1/4 Mgas
J. N 2768'

Map No. **KANSAS** ¹⁰ Sec. ¹⁷ Twp. ²⁷ R. ⁷Well No. ^{-115 max}^{Ray et al} Company

Contractor

FIRST REPORT

SECTION PLAT

²⁰⁰ Ft. from N. Line

Ft. from S. Line

Ft. from E. Line

²⁰⁰ Ft. from W. Line

⁰			

Location

Rig up ^{✓✓}

Drilling and Remarks:

RECORD

Cased _____ in., _____ ft.

Sand _____

Gas _____

Oil _____

Total Depth _____

PRODUCTION

1st 24 hrs. Nat. _____

1st 24 hrs. after shot _____

Gas _____ Cu. Ft.

Dry Hole _____

Abandoned _____

Date

MAR 2 1923

M. A. BENEAR

191

Scout

Map No. **KANSAS** *10* Sec. *17* Twp. *27* R. *7*Well No. *1 Knox**Ray et al*

Company

Contractor

COMPLETED**SECTION PLAT***200* Ft. from N. Line

_____ Ft. from S. Line

_____ Ft. from E. Line

200 Ft. from W. Line

<i>0</i>			

Location _____

Rig up _____

Drilling and Remarks:

*Gas sand 2606-20**T.D. 2768**2 1/4 Million gal
Comp for Gas well***RECORD**

Cased _____ in., _____ ft.

Sand _____

Gas _____

Oil _____

Total Depth _____

PRODUCTION

1st 24 hrs. Nat. _____

1st 24 hrs. after shot _____

Gas _____ Cu. Ft.

Dry Hole _____

Abandoned _____

Date

NOV 3 1923

192

M. A. BENEAR

Scout