


Section 18 Township 31 Range 3 E

Well No. #1 Berry

Company Cliff McCowan

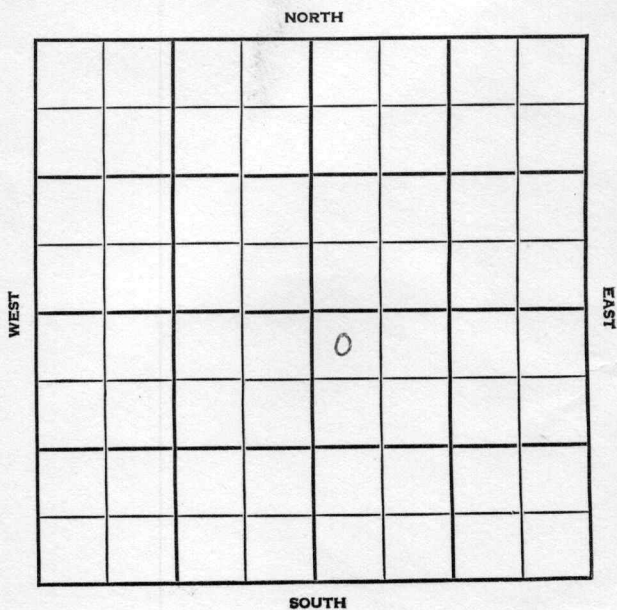

Cowley

KANSAS

SEC. 18	TWP. 31	R. 3E
------------	------------	----------

WELL NO.

#1 Berry

FARM

COMPANY

Cliff McCowan

CONTRACTOR

Capitt


NE Churchill

Ft. from N. Line

Ft. from S. Line

Ft. from E. Line

Ft. from W. Line

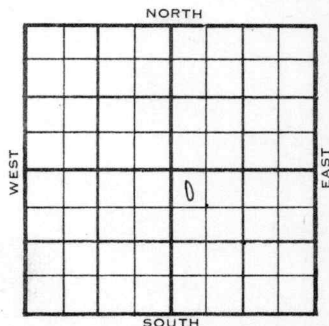

NW NW SE

1956

ELEVATION
1218

REPORT

2-15

Comm. 2-11-56
8" @ 130/125
Drlg. 1510

3-21

DST 2917-33 op 1 hr. rec. 30' muddy
oil, 90' hocm, 830/20"
5½" @ 2923
CO to 2933
FU 110' oil, 110' wtr., 12 hrs., 500 A
S/ 54 go 54 gwph
D & A
Hoov 1788
Stall 2021
KC 2406
A. 2921
TD 2933

ABANDONED

County **Cowley** Elev. **3E**
 Sec. **18** Twp. **31** Rge. **3E**
 Company **Cliff McCowan**
 Farm Name **Berry** No. **1**

TOPS	DEPTH	LOG	DATUM	Loc. in Sec.
Anh.				NW NW SE
Tp.				
H.				
Tr.				
Dg.				
Bl.				
L.				Geol.
K.C.				Contr.
B.K.C.				Capitt
Ce.				Pool
C.				NE Churchill
M.				
M.				
K.				
Mz.				
Mq.				
V.				
S.				
S.				
A.				
R.				
Pe.				
G.				
T.D.				

FIRST REPORT
 D
 FEB 15 56

Date Comm. **2-11-56**
8" @ 130/125 drlg. 1510

Co.
 Lse.
 No.
 Sec.
 T.
 R.

County Cowley Elev. 1218
 Sec. 18 Twp. 31 Rge. 3E
 Company Cliff McCowan
 Farm Name Berry No. 1

TOPS	DEPTH	LOG	DATUM
Anh.			
Tp. <u>Hook</u>	<u>1788</u>		<u>590</u>
H. <u>Stall</u>	<u>2021</u>		<u>803</u>
Tr.			
Dg.			
Bl.			
L.			
K.C.	<u>2406</u>		<u>1188</u>
B.K.C.			
Ce.			
C.			
M.			
M.			
K.			
Mz.			
Me.			
V.			
S.			
S.			
A	<u>2921</u>		<u>1703</u>
R.			
Pe.			
G.			
T.D.	<u>2933</u>		

Loc. in Sec. NW NW SE

Geol. _____
 Contr. Capitt

Pool NE Churchill



Date Comm. 2-11-56 MAR 21 1956
8" @ 130/125 DST 2917-33 open 1 hr.

rec. 30' muddy oil 90' hoem 830/20"
5 1/2" @ 2923 CO to 2933 FU 110' oil
110' wtr. 12 hr. 500 A
S/ 54 go 54 gwph

D & A

Co.

Use.

No.

Sec.

T.

R.