


Section 3 Township 20 Range 10-W

Well Number 2 Wood


Company Ohio

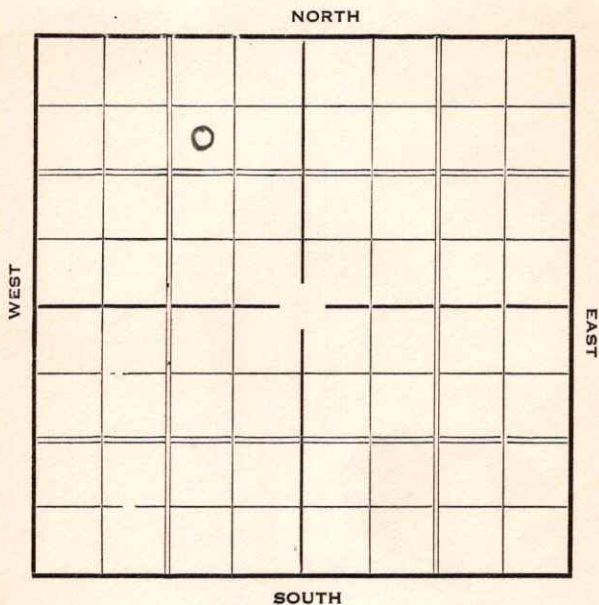

Sec. 3 Twp. 20 R. 10-WWell No. #2 Wood FarmOhio Company990 Ft. from N. Line Ft. from S. Line990 Ft. from E. Line Ft. from W. Line

1785

Elev. 1785

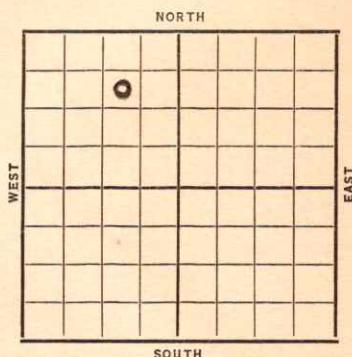

Date	REPORT
1937	
4/14	Location
4/23	Rig, cable.
4/30	20" @ 190'. Drlg. 200'.
5/7	15" @ 755'. Drlg. 1175'.
5/14	12" @ 1726'. Drlg. 1905'.
5/21	10" @ 2160'. T.D. 2330' H.R.
5/28	10" @ 2371'. Drlg. 2615'.
6/4	8" @ 2950'. K.C. 3050'.
	Drlg. 3110'.
6/11	Sil. 3352'. T.D. 3353'.
	S.O.
6/16	7" @ 3352'.
	Sil. 3352'.
	T.D. 3360'. H.F.W.
	ABANDONED

KANSAS *Rice*Map No. _____ Sec. 3 Twp. 20 R. 10WWell No. 2. Wood.Okia

Company _____

Contractor _____

SECTION PLAT

	0		

990 Ft. from N. Line

_____ Ft. from S. Line

990 Ft. from E. Line

_____ Ft. from W. Line

FIRST REPORTLocation ✓

Rig up _____

Drilling and Remarks: _____

RECORD

Cased _____ in., _____ ft.

Sand _____

Gas _____

Oil _____

Total Depth _____

PRODUCTION

1st 24 hrs. Nat. _____

1st 24 hrs. after shot _____

Gas _____ Cu. Ft.

Dry Hole _____

Abandoned _____

Date

APR 14 1937₁₉S. J. LEWIS Scout

Rice KANSAS

Map No. 46 Sec. 3 Twp. 20 R. 10 ^WWell No. 2-WoodOhio

Company

Contractor

ABANDONED

SECTION PLAT

	0		

990 Ft. from N. Line Ft. from S. Line990 Ft. from E. Line Ft. from W. LineLocation Rig up

Drilling and Remarks:

HFW

DVA

RECORD

Cased 7 in., 3352 ft.Sand S11 3352Gas Oil Total Depth 3360

PRODUCTION

1st 24 hrs. Nat. 1st 24 hrs. after shot Gas Cu. Ft.Dry Hole Abandoned

Date

JUN 16 1937

19

H. D. Hatfield Scout