


Section 5 Township 20 Range 10-W

Well Number 3 - Poncin

Company Gulf

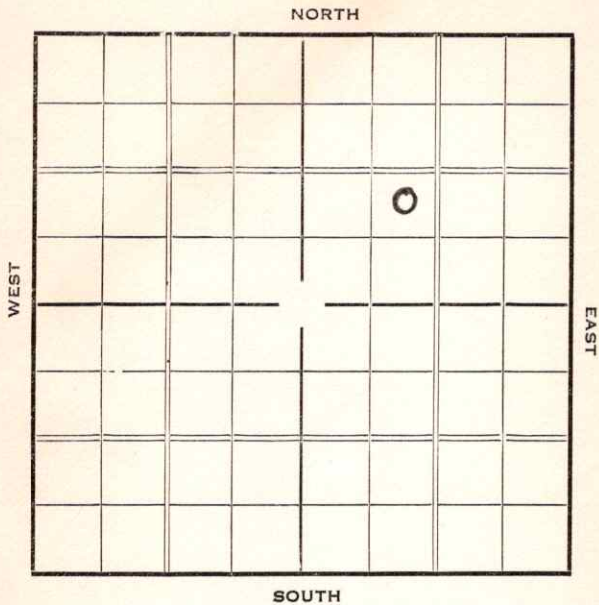

Rice KANSAS

Map No. _____ Sec. 5 Twp. 20 R. 10^W

Well No. 3-Ponin

Gulf Company

Contractor _____

COMPLETED

SECTION PLAT

		0	

_____ Ft. from N. Line

990 Ft. from S. Line

_____ Ft. from E. Line

990 Ft. from W. Line

Location _____

Rig up _____

Drilling and Remarks:

1500 A

Pat-1595

RECORD

Cased 6 in., 3321 ft.

Sand 511 3321

Gas _____

Oil _____

Total Depth 3330

PRODUCTION

1st 24 hrs. Nat. _____

1st 24 hrs. after shot _____

Gas _____ Cu. Ft.

Dry Hole _____

Abandoned _____

Date

JUL 7 1937 19

H. D. Hatfield Scout