
Barton KANSAS

SECTION 21 TOWNSHIP 20S RANGE 12W

WELL NO. #2 Hulme "A"

COMPANY Honaker-Davis

NORTH NE SE SW

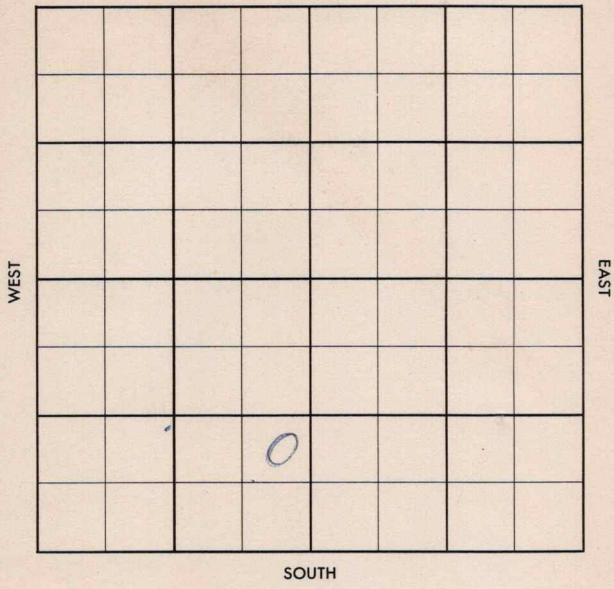

FORM 504-3 SUNRAY

FORM 513 SUNRAY

County Barton Elev.

Sec. 21 Twp. 20 Rge. 12W

Company Honaker-Davis

Farm Name Hulme "A" No. 2

TOPS	DEPTH	LOG	DATUM
Anh.			
T.P.			
H.			
Tr.			
Dg.			
B.L.			
L.			
K.C.			
B.K.C.			
Ce.			
C.			
M.			
M.			
K.			
Mz.			
Mq.			
V.			
S.			
S.			
A			
R.			
P€.			
G.			
T.D.			

Loc. in Sec. NE SE SW

Geol. J. Trimmel

Contr. Co. Tools

Pool Workman NW

AUG 14 '57

FIRST REPORT

Date Comm. M I R T

13

Co. Lse. No. Sec. T. R.

FORM 513 SUNRAY

County Barton Elev. 1937

Sec. 21 Twp. 20 Rge. 12W

Company Honaker-Davis

Farm Name Hulme "A" No. 2

TOPS	DEPTH	LOG	DATUM
Anh.			
Tp.			
H.			
Tr.			
Dg.			
BL.	3152		
L.	3166		
K.C.			
B.K.C.			
Ce.			
C.			
M.			
M.			
K.			
Mz.			
Mo.			
V.			
S.			
S.			
A	3406		
R.			
P€.			
G.			
T.D.	3475		

Loc. in Sec. NE SE SW

Geol J. Trimmel

Contr. Co. Tools

Pool Workman NW

COMPLETE

SEP 25 '57

Date Comm. 8-12-57

MIRT AUG 21 '57 8@ 245w 5½ 3475 woc

No test AUG 29 '57 ✓ in SEP 4 '57

16/3436-40 No show ½

PB 3432 25/3422-30 ½

$ 4 BO ph mcw POP SEP 11 '57

SEP 18 '57 SEP 25 '57 224 BO pd +

4.6 90w ar lucke