


Map No. KANSAS Sec. 18 Twp. 27 R. 7E
Well No. 3 Gill Farm
Lewis Prod Co Company

NORTH

WEST

EAST

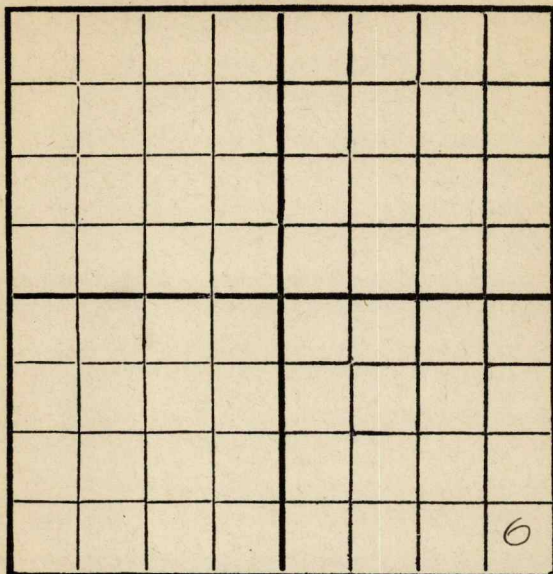

SOUTH

Location _____

Drilling Remarks _____

Rig Up _____

Drilling Remarks _____

RECORD

Cased _____ in. _____ ft.

Sand _____

Gas _____

Oil _____

Total Depth _____

PRODUCTION

1st 24 hrs. Nat. _____

1st 24 hrs. after shot _____


Gas _____ cu. ft. _____

Dry Hole _____

Abandoned _____

Map No. **KANSAS** Sec. 18 Twp. 27 R. 7E
 Well No. 3- Lill Farm
Lewis Prod Co. Company

NORTH

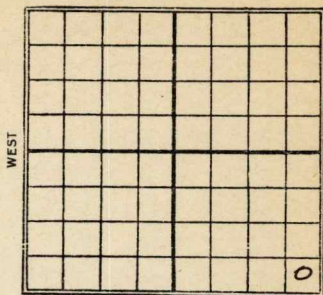

Ft. from N. Line

330 Ft. from S. Line

330 Ft. from E. Line

Ft. from W. Line

SOUTH

Date

REPORT

1929
8/28 Bldg Rig
9/14 1544 up
9/11 dily 610'
9/17 " 1700'
9/25 " 2550'
10/2 Brkn sand from
 2585-2665
 Top line 2750'
 HFW 2825'
 Dry 2840'
10/9 " 3070'
10/16 Lime 2750-3095'
 sand 3192-3204
 S.D. 3204' HFW
10/23 Top line 2750-3095'
 sand 3192-3204' HFW
 T.D. 3204
 Dry & Abandoned

Map No. ¹⁰ **KANSAS** Sec. ^{Butler} 18 Twp. 27 R. 7 ^E

Well No. ^{3 Hill} Lewis Producing Co Company
Contractor

FIRST REPORTS

_____ Ft. from N. Line

330 Ft. from S. Line330 Ft. from E. Line

_____ Ft. from W. Line

SECTION PLAT

			o

Location _____

Rig up Blogg

Drilling and Remarks:

RECORD

Cased _____ in., _____ ft.

Sand _____

Gas _____

Oil _____

Total Depth _____

PRODUCTION

1st 24 hrs. Nat. _____

1st 24 hrs. after shot _____

Gas _____ Cu. Ft.

Dry Hole _____

Abandoned _____

Date

AUG 28 1929**CHAS. L. SHERWOOD**

Butler

Map No. **KANSAS** Sec. 18 Twp. 27 R. 7Well No. 3 Lie
Lewis Prod Co

Company

Contractor

COMPLETE**SECTION PLAT**

			0

Ft. from N. Line

330 Ft. from S. Line

330 Ft. from E. Line

Ft. from W. Line

ABANDONED

Location

Rig up

Drilling and Remarks:

Tap line 2750'-3095'

RECORD

Cased 2 in., ft.

Sand 3192-3204 Hew

Gas

Oil

Total Depth 3204

PRODUCTION

1st 24 hrs. Nat.

1st 24 hrs. after shot

Gas Cu. Ft.

Dry Hole ✓

Abandoned ✓

Date

OCT 23 1929

CHAS. L. SHERWOOD

192

Scout