


Map No. 1 Sec. 10 Twp. 8 R. 1

Well No. 1 F S Hill Farm

Company

NORTH

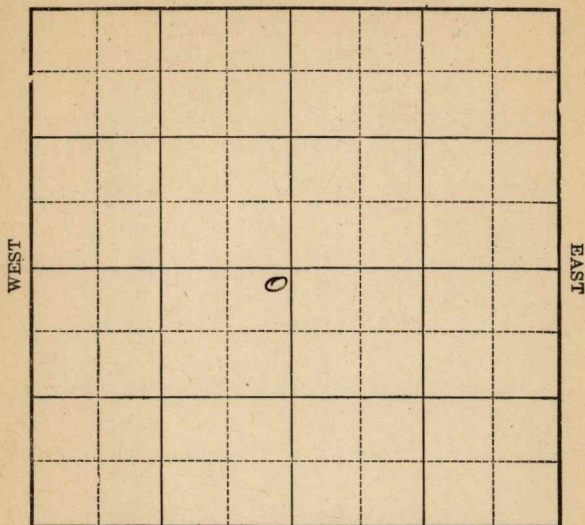

SOUTH

Location _____

Drilling Remarks:

Rig Up_____

Drilling Remarks:

RECORD

Cased_____ in._____ ft.

Sand _____

Gas _____

Oil_____

Total Depth_____

PRODUCTION

1st 24 hrs. Nat. _____

1st 24 hrs. after shot_____

Gas_____cu. ft.

Dry Hole _____

Abandoned _____

Map No. 15 Sec. 18 Twp. 27 R. 7

Well No. 1 F. J. Hill Farm


Miller & Ray Company

200 Ft. from N. Line

_____ Ft. from S. Line

200 Ft. from E. Line

Ft. from W. Line

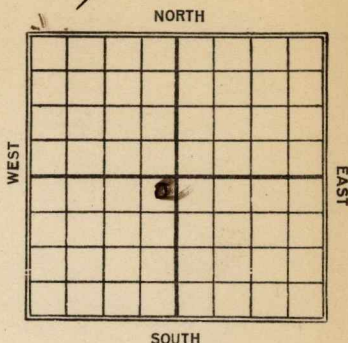

1923

REPORT

829	Reg up
1924	

1924

3/27	Top Line. 2775'
	DEL 9. 2775'

DEL 9. 2775'

Map No. **KANSAS** 10 Sec. 18 Twp. 27 R. 7

Well No. 1 J. T. Lill

Miller & Ray Company

Contractor

FIRST REPORT**SECTION PLAT**

200 Ft. from N. Line

Ft. from S. Line

200 Ft. from E. Line

Ft. from W. Line

	0		

RECORD

Location

Cased in., ft.

Rig up ✓✓

Sand

Drilling and Remarks:

Gas

Oil

Total Depth

PRODUCTION

1st 24 hrs. Nat.

1st 24 hrs. after shot

Gas Cu. Ft.

Dry Hole

Abandoned

Date

SEP 20 1923

M. A. BENEAR

Scout

Map No. KANSAS 10 Sec. 18 Twp. 27 R. 7

 Well No. 1 Lill
Miller & Ray Company
 Contractor

ABANDONED SECTION PLAT

300 Ft. from N. Line

_____ Ft. from S. Line

300 Ft. from E. Line

_____ Ft. from W. Line

	0		

Location _____

Rig up _____

Drilling and Remarks:

Top Line 2775,
2049 2775'

RECORD

Cased _____ in., _____ ft.

Sand _____

Gas _____

Oil _____

Total Depth _____

PRODUCTION

1st 24 hrs. Nat. _____

1st 24 hrs. after shot _____

Gas _____ Cu. Ft.

Dry Hole _____

Abandoned _____

Date

FEB 27 1924

M A BENEAP

_____ 192 _____ Scout