

Barton

KANSAS

SECTION 36 TOWNSHIP 18S RANGE 15W

WELL NO. #3 Howell


COMPANY Wilkinson Drlg.

NORTH

W/2 E/2 SE

WEST

EAST

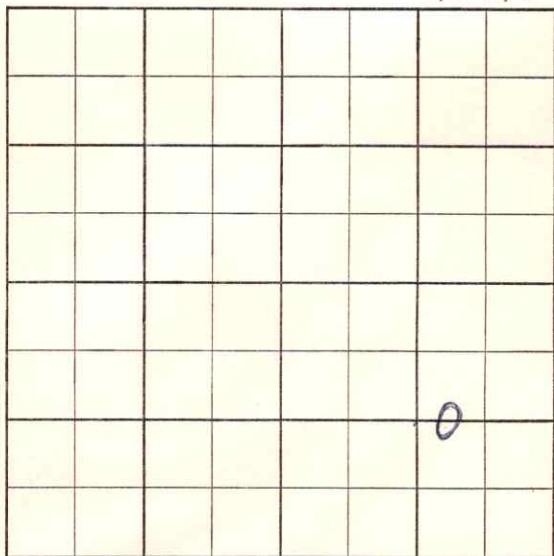

SOUTH

