


Rush

KANSAS

SECTION 20 TOWNSHIP 18 RANGE 16W

WELL NO. 3
#2 Roth

COMPANY Carl Hines

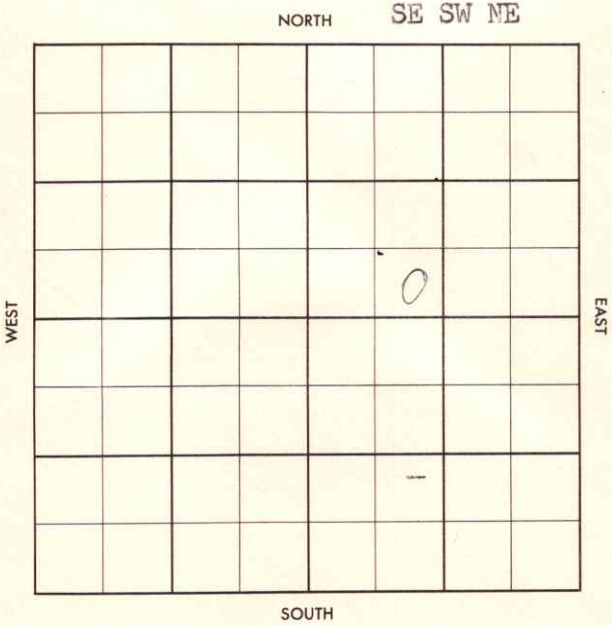

CORRECTION

FORM 513 SUNRAY

County Bush Elev. 1983 Co.
 Sec. 20 Twp. 18 Rge. 16W
 Company Carl Hines
 FarmName Roth No. 23

TOPS	DEPTH	LOG	DATUM	Loc. in Sec.
Anb.	1021			SE SW 1/4
TP.				
H.	3219			
Tr.				
Dg.				
Bl.				
L.	3274			Geol.
K.C.				Contr. <u>Lewis #3</u>
B.K.C.				
Ce.				
C.				
M.				Pool
M.				<u>Otis-Albert</u>
K.				
Mz.				
Ma.				
V.				
S.				
S.				
A.				
R.	3575			
PE.				
G.	<u>Quartz Por 3615</u>			
T.D.	<u>3616</u>			

FEB 27 '57	
COMPLETE	

Date Comm.

Location JAN 30 '57 FEB 6 '57 1-31-57

8⁵/₈ @ 1032/450 # 2286 FEB 13 '57

c/d 3577-92 net 15' 58t 5d.

DST 3577-92 70" 1680' oil

+180' Mdy oil netlw BHP 885/30'

c/d 3592-3616 net 24' DST

3592-3616 1hr 6/7" 920' oil

+50' Mdy w/t 909/30" 5¹/₂

3616 / FEB 20 '57 FEB 27 '57 CO 3601

96/3578-90 Flwd 18 Bo
in 4 hrs died Pol P.
62 Bopd grow 40° no/wto.
P. 25 Bopd no/w

