



Cowley

KANSAS

SEC. 18	TWP. 31	R. 3E
------------	------------	----------

WELL NO. #1 Grant FARM

COMPANY Geo. Nye

CONTRACTOR Capitt

NE Churchill


Ft. from N. Line

Ft. from S. Line

Ft. from E. Line

Ft. from W. Line

NE SW SW

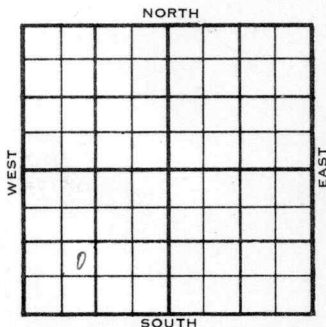

	ELEVATION	REPORT
1956	1198	

1-18 RUR

1-25 Comm. 1-17-56  
 8 5/8" @ 105  
 DST 1667-84 op 1 hr. rec. 30' sgcm,  
 580#  
 D & A  
 Hoover 1674  
 Stal. 1900  
 KC 2278  
 TD 2505'

**ABANDONED**

County Cowley Elev. \_\_\_\_\_  
 Sec. 18 Twp. 31 Rge. 3E  
 Company Geo. Nye  
 Farm Name Grant No. 1

TOPS	DEPTH	LOG	DATUM
Anh.			
Tp.			
H.			
Tr.			
Dg.			
Bl.			
L.			
K.C.			
B.K.C.			
Ce.			
C.			
M.			
M.			
K.			
Mz.			
Ma.			
V.			
S.			
S.			
A.			
R.			
Pe.			
G.			
T.D.			

Loc. in Sec. NE SW SW  
 Geol. \_\_\_\_\_  
 Contr. Capitt  
 Pool NE Churchill

JAN 18 '56  
 FIRST REPORT  
 O

Date Comm. RUR

Co.  
 Lse.  
 No.  
 Sec.  
 T.  
 R.

County Cowley Elev. 1198  
 Sec. 18 Twp. 31 Rge. 3E  
 Company Geo. Vye  
 Farm Name Grant No. 1

TOPS	DEPTH	LOG	DATUM
Anh.			
TP.			
H. <u>Hoover</u>	<u>1674</u>		<u>476</u>
Tr.			
Dg. <u>Stal</u>	<u>1900</u>		<u>702</u>
BL.			
L.			
K.C.	<u>2278</u>		<u>1080</u>
B.K.C.			
Ce.			
C.			
M.			
M.			
K.			
Mz.			
Me.			
V.			
S.			
S.			
A.			
R.			
PE.			
G.			
T.D.	<u>2505</u>		

Loc. in Sec. NE SW SW  
 Geol. \_\_\_\_\_  
 Contr. \_\_\_\_\_  
 Capitt \_\_\_\_\_  
 Pool \_\_\_\_\_  
 NE Churchill



Date Comm. 1-17-56 JAN 25 1956  
8 5/8" @ 105 DST 1667-84 open 1 hr.

rec. 30' sgcm 580#  
D & A

Co.  
 Use.  
 No.  
 Sec.  
 T.  
 R.