

Rush

KANSAS

SECTION 21 TOWNSHIP 18 RANGE 16W

WELL NO. #3 Reinhardt Sanhardt


COMPANY Solar Oil

NORTH

WEST

EAST

SOUTH

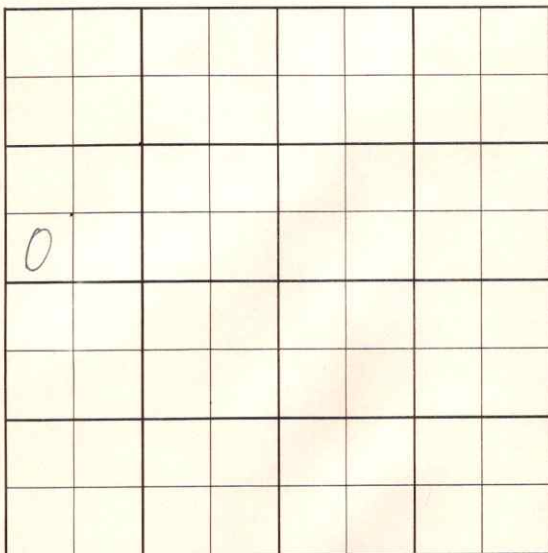

County Rush Elev. 1959 DF
 Sec. 21 Twp. 18S Rge. 16W
 Company Solar Oil
 Farm Name Reinhardt No. 3

Co.

Lse.

No.

Sec.

T.

R.

TOPS	DEPTH	LOG	DATUM	Loc. in Sec.
Anh.				SW SW NW
Tr.				
H.				
Tr.				
Dg.				
BL.				
L.				Geol. <u>Weite</u>
K.C.				Contr.
B.K.C.				<u>Lewis Drlg.</u>
Ce.				<u>#3</u>
C.				Pool
M.				<u>Otis-Albert</u>
M.				
K.				
Mz.				
Mo.				
V.				
S.				
S.				
A.				
R.				
PE.				
G.				
T.D.				

FIRST REPORT

Date Comm. 10-3-56
8" 1002 W/425; D 2885 OCT 10 56

OCT 5 1956

R.G.

CORRECTION

Co.

Loc.

No.

Sec.

T.

R.

County Rush Elev. 1959 DF
 Sec. 21 Twp. 18S Rge. 16W
 Company Solar Oil
 Farm Name ~~Reinhardt~~ Hanhardt No. 3

TOPS	DEPTH	LOG	DATUM	Loc. in Sec.
Anh.				SW SW NW
TP.				
H.	3192			
Tr.				
Dg.				
BL.				
L.	3252			Geol. White
K.C.				Contr.
B.K.C.				Lewis Drlg.
Ce.	3523			#3
C.				Pool
M.				Otis-Albert
M.				
K.				
Mz.				
Ma.				
V.				
S.				
S.				
A.				
R.	3555			
Pe.				
G.				
TD.	3601			

NOV 7 '56
 COMPLETE

Date Comm. 10-3-56

8" 1002 w/425; D 2885 OCT 17 '56

crd 3556-73 Full rec DST 3556
 -73 50" G/2" ga 1.930 MCF/15"
 net 200' clean oil FP 150-220
 BHP 835 crd 3573-3601 Full rec
 DST 3573-3601 1hr G/1hr 180'
 HOCM FP 75 BHP 690 5 1/2
 3599/100 OCT 24 '56 RUCT OCT 31 '56
 CO 3582 41/3566-71 No test

NOV 7 F/w 25 Bopd no/w tr

21-18-16

sw sw ml