

Rice


KANSAS

SECTION 3 TOWNSHIP _____ RANGE 10W

WELL NO. #1 McFarland

COMPANY Isern Drlg.

NORTH

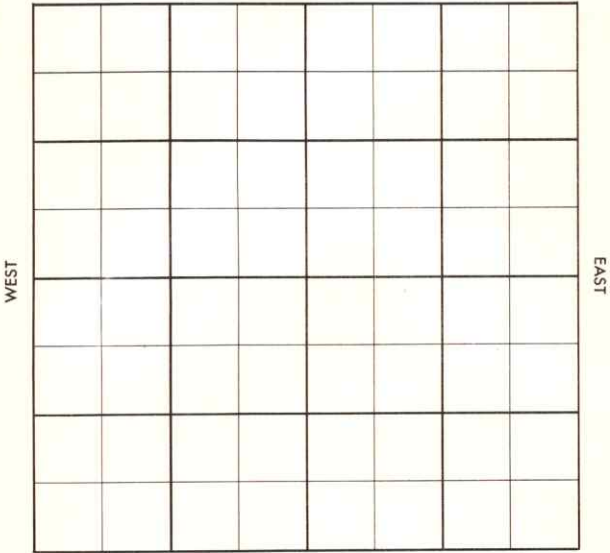

SOUTH

County Rice Elev. _____
 Sec. 3 Twp. 20 Rgs. 10W
 Company Isern Drlg.
 FarmName McFarland No. 1

TOPS	DEPTH	LOG	DATUM	Loc. in Sec.
Anh.				SW SE SE
Tp.				
H.				
Tr.				
Dg.				
Bl.				
L.				Geol. _____
K.C.				Contr. _____
B.K.C.				
Ce.				Co. tools
C.				
M.				Pool
M.				Chase-Silica
K.				
Mz.				
Me.				
V.				
S.				
S.				
A.				
R.				
Pe.				
G.				
T.D.				

FIRST REPORT
 APR 11 1956

Date Comm. surface set

APR 17 1956

R. G.

Co.

Lse.

No.

Sec.

T.

R.

County Rice Elev. 1786 DF
 Sec. 3 Twp. 20 Rgs. LOW
 Company Isom Drilling
 Farm Name McFarland No. 1

TOPS	DEPTH	LOG	DATUM	Loc. in Sec.
Anh.	447			SW SE SE
TP.				
H.	2888			
Tr.				
Dg.				
BL.	3014		1228	
L.	3033		1847	
K.C.				Geol.
B.K.C.				Contr.
Ce.				Co. tools
C.				
M.				Pool
M.				Chase-Silica
K.				
Mz.				
Me.				
V.				
S.	54	3352	1566	BANDONED
S.				
A.		3376	1580	
R.				
PE.				
G.				
TD.		3401		

Date Comm.

APR 25 1956

surface set APR 18 '56 4-11-56 8 5/8 @
 202/150 @ 2651 APR 25 '56 DST 3330-
 78 lbs rec 30' Md BHP 0/
 D&A