
Barton KANSAS

SECTION 21 TOWNSHIP 20 RANGE 12W

WELL NO. #1 Hulme "B"

COMPANY Honaker-Davis

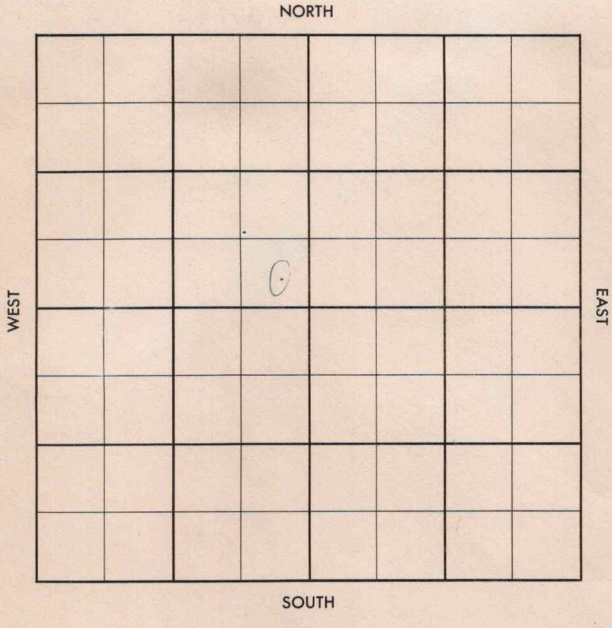

FORM 504-3 SUNRAY

FORM 513 SUNRAY

County Barton Elev. Co.

Sec. 21 Twp. 20 Rge. 12W

Company Honaker-Davis

Farm Name Hulme "D" No. 1

TOPS	DEPTH	LOG	DATUM
Anh.			
T.P.			
H.			
Tr.			
Dg.			
B.L.			
L.			
K.C.			
B.K.C.			
Ce.			
C.			
M.			
M.			
K.			
Mz.			
Mq.			
V.			
S.			
S.			
A			
R.			
P€.			
G.			
T.D.			

Loc. in Sec. SE SE NW

Geol.

Contr. Co. tools Lse.

Pool MW Workman

FIRST REPORT

JAN 16 '57

Date Comm.

M I R

13

FORM 513 SUNRAY

County Barton Elev. 1846

Sec. 21 Twp. 20 Rge. 12W

Company Honaker-Craig

Farm Name Hulme "A" No. 1

TOPS	DEPTH	LOG	DATUM
Anh.			
Tp.	2820		
H.	3033		
Tr.			
Dg.			
B.L.	3165		
L.	3180		
K.C.			
B.K.C.			
Ce.			
C.			
M.			
M.			
K.			
Mz.			
Mo.			
V.			
S.			
S.			
A	3429		
R.			
P€.			
G.			
T.D.	3505		

Loc. in Sec. SE SE NW

Geol.

Contr. Co. tools

Pool NW Workman

APR 17 '57

COMPLETE

Date Comm. 1-17-57

MTR JAN 23 57 8 3/8 230

1175 ID 2970 JAN 30 57 (4 DST)

5 1/2 @ 3504 RUCT FEB 6 57

DST 3309-25 1hr 20' WM

BHP 1040

DST 3431-55 30" rec 10' Md

BHP 620 DST 3455-69

of 25" rec 5' OCM BHP 900/1hr

co PF 24 3452-62 No - no tst.

FORM 513-1 SUNRAY

PB 3448 24/3436-44 ½
no inc. ~~60~~ PF 3469-73 ½
No show PB 3400 18/3372
-76 N.S. CO 3505 Flac
58 Bwph PB 3300 12/
3223-27 8/3202-04 12/3182
-85 (2) tst FEB 13 '57 FEB 20 '57
1½ Boph no/w 4 hrs)
Pot. FEB 27 '57 MAR 6 '57 MAR 13 '57 MAR 20 '57 X
Back dope on DST (1st Page) MAR 27 '57
APR 3 '57 APR 10 '57 APR 17 '57 Ph P. 51
Bopd + 2% wtr
grav 36°

21-20-12