

Cowley

KANSAS

SECTION 18 TOWNSHIP 31 RANGE 3 E

WELL NO. #1 Shoup

COMPANY Geo. Fye

NORTH

	0						

WEST

EAST

SOUTH

Cowley

KANSAS

SEC.	TWP.	R.
18	31	3E

WELL NO.

#1 Shoup

FARM

COMPANY

Geo Vye

CONTRACTOR

Capitt


Wildcat

_____ Ft. from N. Line

_____ Ft. from S. Line

_____ Ft. from E. Line

_____ Ft. from W. Line

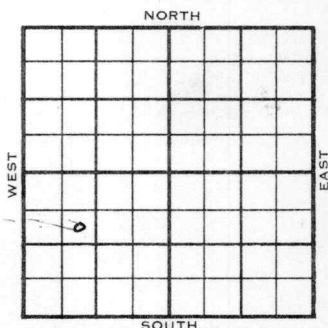

SE NW SW

1955	ELEVATION	REPORT
	1199	

11/29

Comm 10-5-55

8" @ 210/175

Drlg 278

1956

1-25

DST 1671-85 op 1 hr. rec. 365' clean oil 170#

DST 1906-25 op 1 hr. rec. 30' mud, # 150' sw, 510#

DST 2326-35 op 1 hr. rec. 15' socm, 120#

DST 2380-2416 op 1 hr. rec. 30' socm 80#

DST 2418-30 op 1 hr. rec. 105' clean oil 60' vho&gcm, 830#

DST 2768-86 op 1/2 hr. rec. 5' hocm 700/15"

5 1/2 @ 2783

CO to 2786, 500 A

SSO & W

DD 2789, PB 2470

40/ 2420-30, frac

S/ 100 bo 2 hrs.,

Comp. 37 bopd, 20% wtr.

Hoover 1678

B. Stal 2030

V Ye 2420

BKC 2544

TD 2786'

Stal 1903

KC 2282

K. Sd 2430

A. 2780

DX-78

COMPLETED

County

Cowley

Elev.

Sec.

18

Twp.

31

Rge.

3E

Company

Geo. Vye

Farm Name

Shoup

No.

1

TOPS

DEPTH

LOG

DATUM

Loc. in Sec.

Anh.

SE NW SW

Tp.

H.

Tr.

Dg.

Bl.

L.

K.C.

Geol.

B.K.C.

Contr.

Ce.

Capitt

C.

M.

Pool

M.

K.

Wildcat

Mz.

Mq.

V.

S.

S.


A.

R.

Pe.

G.

T.D.

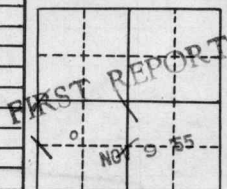

Date Comm.

10-5-55

8" @ 210/175 drlg. 278

County Cowley Elev. 1199
 Sec. 18 Twp. 31 Rge. 3E
 Company Geo. Vye
 Farm Name Shoup No. 1

TOPS	DEPTH	LOG	DATUM
Anh.			
Tp.			
H. <u>Harper</u>	<u>1678</u>		<u>479</u>
Tr. <u>Ital</u>	<u>1903</u>		<u>704</u>
Dg. <u>B. Ital</u>	<u>2030</u>		<u>837</u>
BL.			
L.			
K.C.	<u>2282</u>		<u>1083</u>
B.K.C.			
Ce.			
C.			
M. <u>Vye</u>	<u>2420</u>		<u>1231</u>
M.			
K. <u>Ad.</u>	<u>2430</u>		<u>1231</u>
Mz. <u>B.K.C.</u>	<u>2544</u>		<u>1345</u>
Mq.			
V.			
S.			
S.			
A.	<u>2780</u>		<u>1581</u>
R.			
PE.			
G.			
T.D.	<u>2786</u>		

Loc. in Sec. SE NW SW

Geol. _____
 Contr. _____
 Capitt

Pool _____
 Wildcat

Date Comm. 10-5-55

JAN 25 1956

8" @ 210/175 DST 1671-85 open 1 hr.
 rec. 365' clean oil 170# DST 1906-25
 open 1 hr. rec. 30' mud 150' sw
 510# DST 2326-35 open 1 hr. rec.
 15' socm 120# DST 2380-2416
 open 1 hr. rec. 30' socm 80#
 DST 2418-30 open 1 hr. rec. 105' clean
 oil 60' vho & gcm 830#

DST 2768-86 open $\frac{1}{2}$ hr. rec. 5' hoem
700/15" 5 $\frac{1}{2}$ " @ 2783 CO to 2786
500 A SSO & W DD 2789 PB 2470
40/ 2420-30 frac S/ 100 bo 2 hr.
Comp. 37 bopd 20% wtr.

R. G.

FEB 6 1956