


DX 78-1 Rice

KANSAS

Section 3 Township 20 Range 10W
Well No. #2 Bever
Company Phillips Pet

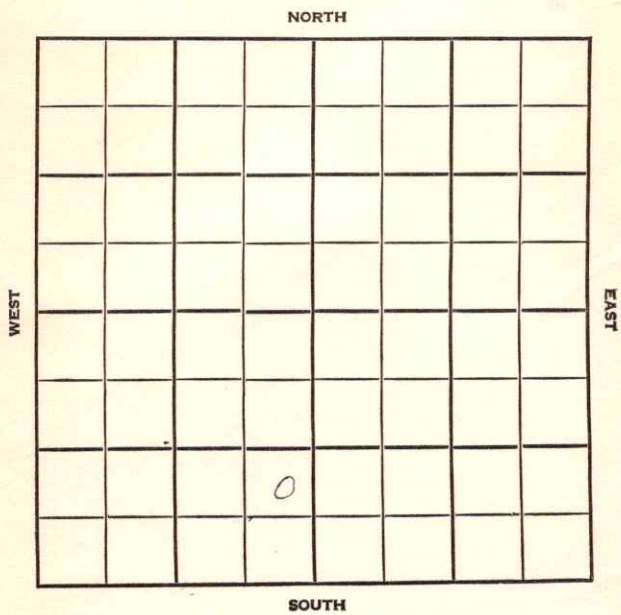

Rice

KANSAS

SEC.	TWP.	R.
3	20	10W

WELL NO.

#2 Bever

FARM

COMPANY

Phillips Petr.

CONTRACTOR

Co. Tools

Chase-Silica


_____ Ft. from N. Line

_____ Ft. from S. Line

_____ Ft. from E. Line

_____ Ft. from W. Line

NE SE SW

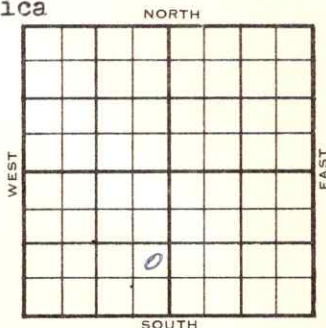

1956

ELEVATION

1797

REPORT

3-21 Comm. 3-15-56
 9" @ 326/195
 Drlg. 2360

4-11 7" @ 3387/65
 CO to 3358, 16/ 3354-58
 S/ 87.76 bo in 6 hrs.
 Comp. 108 bopd

H.	2906	2908
Tr.	2930	2930
Dg.	2939	2944
BL.	3032	3035
L.	3050	3052
BKC	3321	
Ce. Marm	3326	3326
C. Sd.	3358	3354
A.	3388	3385

TD 3391

COMPLETED

County **Rice** Elev. **10W**
 Sec. **3** Twp. **20** Rge. **10W**
 Company **Phillips Pet.**
 Farm Name **Bever** No. **2**

TOPS	DEPTH	LOG	DATUM	Loc. in Sec.
Anh.				NE SE SW
Tp.				
H.				
Tr.				
Dg.				
Bl.				
L.				Geol.
K.C.				Contr.
B.K.C.				Co. tools
Ce.				Pool
C.				Chase-Silica
M.				
M.				
K.				
Mz.				
Mq.				
V.				
S.				
S.				
A.				
R.				
Pe.				
G.				
T.D.				

FIRST REPORT

MAR 21 '56

Date Comm. **3-15-56**
9" @ 326/195 drlg. 2360

12

County Pice Elev. 1797
 Sec. 3 Twp. 20 Rge. 10W
 Company Phillips Pet.
 Farm Name Bever No. 2

TOPS	DEPTH	LOG	DATUM	Loc. in Sec.
Anh.				NE SE SW
Tp.				
H.	<u>2906</u>	<u>2908</u>		
Tr.	<u>2930</u>	<u>2930</u>		
Dg.	<u>2939</u>	<u>2944</u>		
Bl.	<u>3032</u>	<u>3035</u>		
L.	<u>3050</u>	<u>3052</u>	<u>1255</u>	Geol.
K.C.				
B.K.C.	<u>3321</u>		<u>1524</u>	Contr.
Ce. <u>Marm</u>	<u>3326</u>	<u>3326</u>	<u>1529</u>	Co. tools
C. <u>sa</u>	<u>3358</u>	<u>3354</u>	<u>1557</u>	
M.				Pool
M.				Chase-Silica
K.				
Mz.				
Mq.				
V.				
S.				
S.				
A.	<u>3388</u>	<u>3385</u>	<u>1588</u>	COMPLETE
R.				
Pe.				
G.				
T.D.	<u>3391</u>			

Date Comm. 3-15-56 APR 11 1956
9" @ 326/195 7" @ 3387/65
CO to 3358 16/ 3354-58 S/ 87.76 bo in
6 hr. Comp. 108 bopd