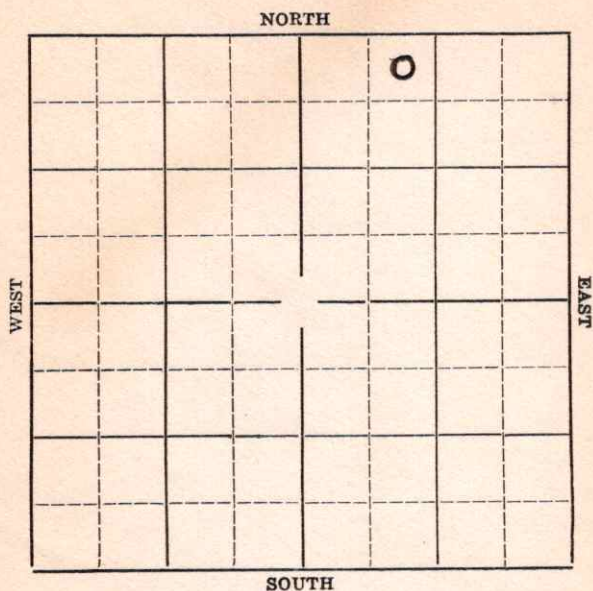


Rice

KANSAS

Section 5 Township 20 Range 10-WWell Number 3 PoncinCompany Tatlock

KANSAS *Rice*Map No. _____ Sec. 5 Twp. 20 R. 10WWell No. 3 PoncinTallock

Company _____

Contractor _____

SECTION PLAT

		0	

330 Ft. from N. Line

_____ Ft. from S. Line

_____ Ft. from E. Line

990 Ft. from W. Line

FIRST REPORT

Location _____

Rig up _____

Drilling and Remarks:

Rigging up

RECORD

Cased _____ in., _____ ft.

Sand _____

Gas _____

Oil _____

Total Depth _____

PRODUCTION

1st 24 hrs. Nat. _____

1st 24 hrs. after shot _____

Gas _____ Cu. Ft.

Dry Hole _____

Abandoned _____

Date

APR 21 1937

S. J. LEWIS

Scout

Rice KANSAS

Map No. _____ Sec. 5 Twp. 20 R. 10^WWell No. 3-PoncinTatlock Company

Contractor

COMPLETED

330 Ft. from N. Line

_____ Ft. from S. Line

_____ Ft. from E. Line

990 Ft. from W. Line

SECTION PLAT

		0	

Location _____

Rig up _____

Drilling and Remarks:

Pot 1782

Based on 6-hr
Test

RECORD

Cased 7 in., 3296 1/2 ft.Sand 511 3300Gas (corrected)

Oil _____

Total Depth 3307 1/2

PRODUCTION

1st 24 hrs. Nat. _____

1st 24 hrs. after shot _____

Gas _____ Cu. Ft.

Dry Hole _____

Abandoned _____

Date

MAY 26 1937 19 H. D. Hatfield Scout