

Kansas

Map No. _____ Sec. *18* Twp. *31* R. *3 E*

Well No. *1-Willis* Farm
Texas Oil Company


330 Ft. from N. Line

_____ Ft. from S. Line

_____ Ft. from E. Line

330 Ft. from W. Line

1927

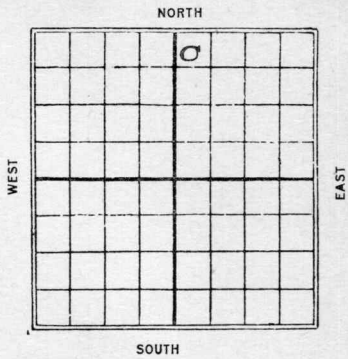

Date	REPORT
<i>2/9</i>	<i>Location</i>
<i>2/16</i>	<i>—</i>
<i>2/23</i>	<i>—</i>
<i>3/2</i>	<i>—</i>
<i>3/9</i>	<i>—</i>
<i>3/16</i>	<i>—</i>
<i>3/23</i>	<i>Rig</i>
<i>3/30</i>	<i>Rigging up</i>
<i>4/6</i>	<i>Spud 350</i>
<i>4/13</i>	<i>Drlg 580 - H.F.W.</i>
<i>4/20</i>	<i>Drlg 830</i>
<i>4/27</i>	<i>T.D. 1245 strat remaining 12"</i>
<i>5/4</i>	<i>Drlg 1450</i>
<i>5/11</i>	<i>" 1630</i>
<i>5/18</i>	<i>Sand 1960-75 - H.F.W.</i>
	<i>Drlg in Sand 2070-</i>
<i>5/25</i>	<i>Drlg 2462</i>
<i>6/1</i>	<i>T.D. 2472 - u.R. 8"</i>
<i>6/8</i>	<i>—</i>
<i>6/15</i>	<i>—</i>
<i>6/22</i>	<i>T.D. 2525 - fishing tools</i>
<i>6/29</i>	<i>Drlg 2835-</i>

7/6 - Chat 3055-70-

Drly 3100-

7/13 - Drly 3165-

7/20 - Top Wilcox 3286 - (S.L.M.)

water 3299-3303 - T.D. W.R.5'

7/27 - T.D. 3414 - (S.L.M.) - H.F.W.

S.D. for orders

8/3 - T.D. 3414

D. & A.

Map No. 1 ~~KANSAS~~ Sec. 18 Twp. 31 R. 2E

Well No. 1 Willis

Texas Oil Company

Contractor

SECTION PLAT

330 Ft. from N. Line

----- Ft. from S. Line

----- Ft. from E. Line

330 Ft. from W. Line

		0	

FIRST REPORTS

Location ✓

Rig up -----

Drilling and Remarks:

RECORD

Cased ----- in., ----- ft.

Sand -----

Gas -----

Oil -----

Total Depth -----

PRODUCTION

1st 24 hrs. Nat. -----

1st 24 hrs. after shot -----

Gas ----- Cu. Ft.

Dry Hole -----

Abandoned -----

Date

FEB 9 1927

S. J. LEWIS

192

Scout

Map No. 1 **KANSAS** Sec. 18 Twp. 31 R. 3E

Well No. 1 Willis

Texas Oil Company

Contractor

SECTION PLAT

330 Ft. from N. Line

----- Ft. from S. Line

----- Ft. from E. Line

330 Ft. from W. Line

ABANDONED

		0	

Location -----

Rig up -----

Drilling and Remarks:

T 3414

II & A

RECORD

Cased ----- in., ----- ft.

Sand -----

Gas -----

Oil -----

Total Depth -----

PRODUCTION

1st 24 hrs. Nat. -----

1st 24 hrs. after shot -----

Gas ----- Cu. Ft.

Dry Hole -----

Abandoned -----

Date

AUG 3 1927

S. J. LEWIS Scout

Butler

MAP NO. K1 **KANSAS** SEC. 18 TWP. 31S R. 3E

WELL NO. 1 Miller
Dennis COMPANY

CONTRACTOR

SECTION PLAT

ABANDONED

_____ FT. FROM N. LINE
_____ FT. FROM S. LINE
_____ FT. FROM E. LINE
_____ FT. FROM W. LINE

		0	

RECORD

LOCATION _____

CASED _____ IN. _____ FT.

RIG UP _____

SAND _____

DRILLING AND REMARKS:

GAS _____

OIL _____

TOTAL DEPTH 3416

075

PRODUCTION

1ST 24 HRS. NAT. _____

1ST 24 HRS. AFTER SHOT _____

GAS _____ CU. FT.

DRY HOLE

ABANDONED

DATE

8-19 192 7

SCOUT