

Map No. **KANSAS** Sec. **19** Twp. **31** R. **3 E**

Well No. 1 - Martin Farm
Durham-Work et al Company

NORTH

WEST

EAST

SOUTH

Location

Drilling Remarks

Rig Up_____

Drilling Remarks

RECORD

Cased.....in.ft.

Sand _____

Gas

Oil _____

Total Depth.....

PRODUCTION

1st 24 hrs. Nat.

1st 24 hrs. after shot.....

Gas..... cu. ft.

Dry Hole.....

Abandoned

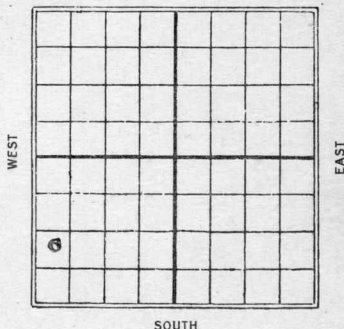
Map No. KANSAS Sec. 19 Twp. 31 R. 3EWell No. 1-Martin Farm
Durham-Work et al Company

NORTH

_____ Ft. from N. Line

990 Ft. from S. Line

_____ Ft. from E. Line

220 Ft. from W. Line1928

Date

REPORT

5/2	Location
5/9	
5/16	Bldg rig
5/23	Rigging up-
5/31	
6/6	Spud 35 - S.D.
6/13	Spud 250
6/20	Drlg 430
6/27	" 785
7/3	" 1155
7/11	T.S. 1902 T.D. 1959
	1 1/2 bbls oil per hr
7/18	T.D. 1967 - Will shoot
7/25	T.D. 1967 - S.D.
8/1	
8/8	Top sand 1902
	T.D. 1967
	Pumping 15 bbls

Map No. KANSAS Sec. 19 Twp. 31 R. 2E

Well No. 1 Martin

Turham-Hock et al Company

Contractor

SECTION PLAT

_____ Ft. from N. Line

990 Ft. from S. Line

_____ Ft. from E. Line

220 Ft. from W. Line

FIRST REPORTS

0			

Location ✓

Rig up _____

Drilling and Remarks:

RECORD

Cased _____ in., _____ ft.

Sand _____

Gas _____

Oil _____

Total Depth _____

PRODUCTION

1st 24 hrs. Nat. _____

1st 24 hrs. after shot _____

Gas _____ Cu. Ft.

Dry Hole _____

Abandoned _____

Date

MAY 2 1928

192

S. J. LEWIS

Scout

Map No. **KANSAS** Sec. 19 Twp. 31 R. 3E

Well No. 1 Martin

Thurham-York & Co. Company

Contractor

SECTION PLAT

0			

-----Ft. from N. Line

990 Ft. from S. Line

-----Ft. from E. Line

220 Ft. from W. Line

COMPLETED

Location -----

Rig up -----

Drilling and Remarks:

Top Cased 1902

Total Depth 1967

Pumping 1500 ft.

RECORD

Cased ----- in., ----- ft.

Sand -----

Gas -----

Oil -----

Total Depth -----

PRODUCTION

1st 24 hrs. Nat. -----

1st 24 hrs. after shot -----

Gas ----- Cu. Ft.

Dry Hole -----

Abandoned -----

Date

AUG 8 1928

S. J. LEWIS

Scout