


Barton

KANSAS

SECTION 21 TOWNSHIP 20 S RANGE 12 W

WELL NO. # 5 Hulme "B"

COMPANY Honaker-Davis et al

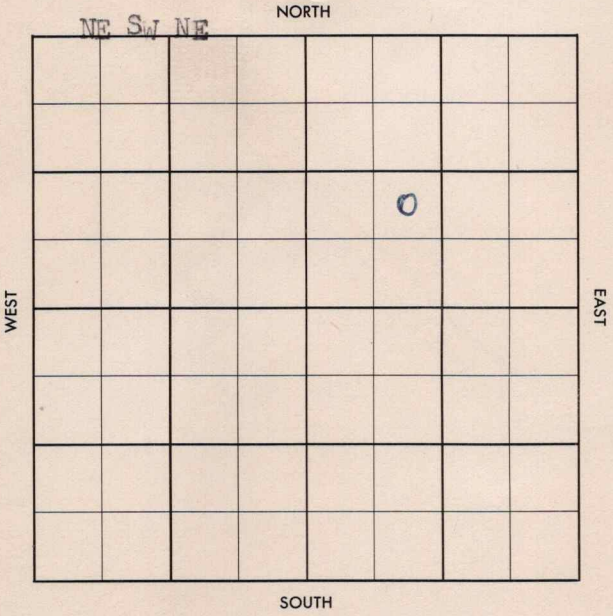

827547

FORM 513 SUNRAY

County Barton Elev. \_\_\_\_\_  
 Sec. 21 Twp. 20S Rge. 12W  
 Company Honaker-Davis etal  
 Farm Name Hulme "B" No. 5

TOPS	DEPTH	LOG	DATUM	Loc. in Sec.
Anh.				NE SW NE
Tp.				
H.				
Tr.				
Dg.				
Bl.				
L.				Geol. _____
K.C.				Contr. _____
B.K.C.				
Ce.				Co. rig #3
C.				
M.				Pool
M.				Workman NW
K.				
Mz.				
Me.				
V.				
S.				
S.				
A.				
R.				
Pe.				
G.				
T.D.				

FIRST REPORT

	AUG 21 57	

Date Comm. MIRT

~~13~~

Co.  
Lse.  
No.  
Sec.  
T.  
R.

County ~~Barton~~ Elev. 1836  
 Sec. 21 Twp. 208 Rge. 12W  
 Company Honaker-Davis et al  
 Farm Name Hulme "B" No. 5

TOPS	DEPTH	LOG	DATUM	Loc. in Sec.
Anh.				NE SW NE
Tr.				
H.	3012			
Tr.				
Dg.				
BL.	3132			
L.	3150			
K.C.				Geol.
B.K.C.				Contr.
Ce.				Co. rig #3
C.				
M.				Pool
M.				Workman NW
K.				
Mz.				
Mq.				
V.				
S.				
S.				
A	3383			
R.				
PE.				
G.				
T.D.	3475			

SEP 25 '57  
 0  
 COMPLETE

Date Comm.

MIRT AUG 28 '57 8-19-57 858 243  
DST 3151-74 1hr rec 6 1/2"  
ga 1.930 MCF rec 90' Md FP  
200-340 1128/20" DST 3274  
-94 of 1hr rec 41' HO 6CM  
450/20" 5 1/2 3473 / w o c t  
SEP 4 '57 25/3430 -36 \$ 10 Boph  
now w Nat pop SEP 11 '57 SEP 18 '57  
SEP 25 '57 202 Boph now