

Map No. KANSAS Sec. 19 Twp. 31 R. 3E


Well No. 1 - Stout Farm
Durham, Stokes Company

220 Ft. from N. Line

..... Ft. from S. Line

..... Ft. from E. Line

220 Ft. from W. Line

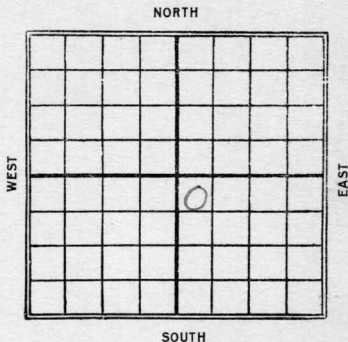

1928

Date

REPORT

Date	REPORT
1/18	Location
1/25	Log
1/31	Rigging up.
2/15	Spud
2/22	Spud + S.D.
2/29	Drly 450
3/7	" 1100
3/14	" 1900
3/21	Top sand 1910. T.D. 1976 - hole full water - Shutdown.
3/28	T.D. 1976 - Will drill deeper -
4/4	Drilling 2020 -
4/11	" 2170 - H.F.W.
4/18	Sand 2170 - 2215 - H.F.W. T.D. 2215 - D. + A.
4/18	sd. 2170 - 2215 H.F.W. T.D. 2215 D. + A.

2nd copy

Cowley

Map No. KANSAS Sec. 19 Twp. 31 R. 3E

Well No. 1 Stout

Durham & Horne Company

Contractor

SECTION PLAT

220 Ft. from N. Line

_____ Ft. from S. Line

_____ Ft. from E. Line

220 Ft. from W. Line

		10	

FIRST REPORTS

Location V

Rig up _____

Drilling and Remarks:

RECORD

Cased _____ in., _____ ft.

Sand _____

Gas _____

Oil _____

Total Depth _____

PRODUCTION

1st 24 hrs. Nat. _____

1st 24 hrs. after shot _____

Gas _____ Cu. Ft.

Dry Hole _____

Abandoned _____

Date

JAN 18 1928

192

S. J. LEWIS

Scout

Butler

K1 MAP NO. KANSAS SEC. 19 TWP. 31S R. 3E

WELL NO. 1 Start
Durham - North COMPANY

CONTRACTOR

SECTION PLAT

ABANDONED

_____ FT. FROM N. LINE
_____ FT. FROM S. LINE
_____ FT. FROM E. LINE
_____ FT. FROM W. LINE

		o	

RECORD

LOCATION _____

RIG UP _____

DRILLING AND REMARKS:

1910 Φ
1943-1976
H.2.H.
2215

CASED _____ IN. _____ FT.

SAND _____

GAS _____

OIL _____

TOTAL DEPTH 1976

PRODUCTION

1ST 24 HRS. NAT. _____

1ST 24 HRS. AFTER SHOT _____

GAS _____ CU. FT.

DRY HOLE

ABANDONED

DATE 3/21 1928

SCOUT

Map No. **KANSAS** Sec. *19* Twp. *31* R. *3E*

Well No. *1 Stout*

Turham & Works Company

Contractor

SECTION PLAT

220 Ft. from N. Line

----- Ft. from S. Line

----- Ft. from E. Line

220 Ft. from W. Line

		10	

ABANDONED

Location -----

Rig up -----

Drilling and Remarks:

Ed. 2170-2215 HFW

T & A 2215

T & A

RECORD

Cased ----- in., ----- ft.

Sand -----

Gas -----

Oil -----

Total Depth -----

PRODUCTION

1st 24 hrs. Nat. -----

1st 24 hrs. after shot -----

Gas ----- Cu. Ft.

Dry Hole -----

Abandoned -----

Date

APR 18 1928

S. J. LEWIS

Scout