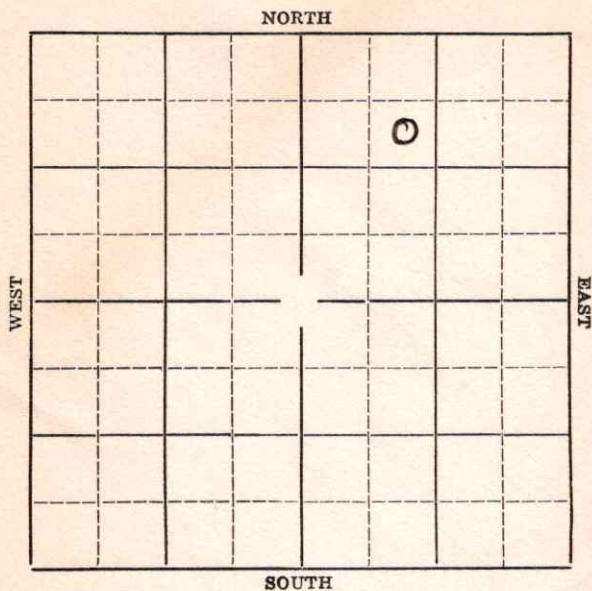


Rice

KANSAS

Section 5 Township 20 Range 10-WWell Number 4 PoncinCompany Tatlock

KANSAS *Rice*Map No. _____ Sec. 5 Twp. 20 R. 10WWell No. 4 *Pocin*Tallock _____ Company_____
Contractor**SECTION PLAT**

		o	

990 Ft. from N. Line

_____ Ft. from S. Line

_____ Ft. from E. Line

990 Ft. from W. Line**FIRST REPORT**

Location _____

Rig up _____

Drilling and Remarks:

*RCY***RECORD**

Cased _____ in., _____ ft.

Sand _____

Gas _____

Oil _____

Total Depth _____

PRODUCTION

1st 24 hrs. Nat. _____

1st 24 hrs. after shot _____

Gas _____ Cu. Ft.

Dry Hole _____

Abandoned _____

Date

APR 21 1937 19

S. J. LEWIS Scout

KANSAS

Map No. _____ Sec. 5 Twp. 20 R. 10^WWell No. 4-PoncinTatlock Company

Contractor

COMPLETED

990 Ft. from N. Line

_____ Ft. from S. Line

_____ Ft. from E. Line

990 Ft. from W. Line

SECTION PLAT

		0	

Location _____

Rig up _____

Drilling and Remarks:

Rot- 1406(6-hr Test X 4 Less1090

RECORD

Cased 7 in., 3308 ft.Sand 511 3308

Gas _____

Oil _____

Total Depth 3314

PRODUCTION

1st 24 hrs. Nat. _____

1st 24 hrs. after shot _____

Gas _____ Cu. Ft.

Dry Hole _____

Abandoned _____

Date

MAY 26 1937 19H. D. Hatfield

Scout