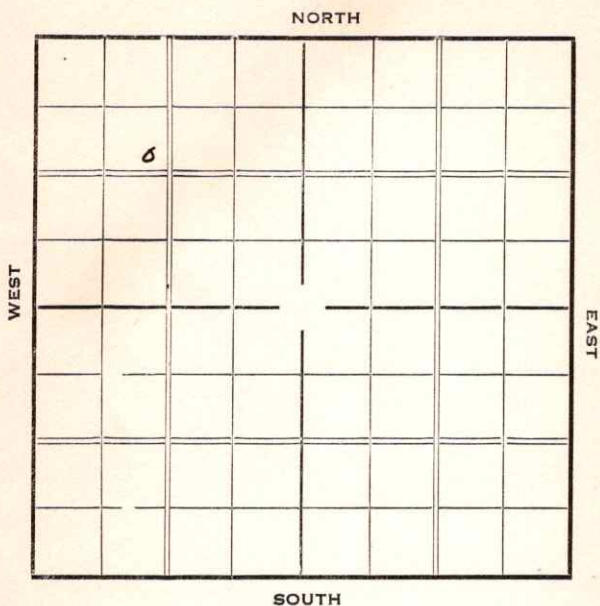


RICE

KANSAS

Section 5 Township 20 Range 10WWell Number 8 Stoltz Jr.Company Gulf

Map No. 46 Sec. 5 Twp. 20 R. 10WWell No. 8 Stoltz Jr.Company G. Y. J.

Contractor _____

SECTION PLAT

0			

990 Ft. from N. Line

_____ Ft. from S. Line

_____ Ft. from E. Line

990 Ft. from W. Line

FIRST REPORT

Location _____

Rig up _____

Drilling and Remarks:

Rig

RECORD

Cased _____ in., _____ ft.

Sand _____

Gas _____

Oil _____

Total Depth _____

PRODUCTION

1st 24 hrs. Nat. _____

1st 24 hrs. after shot _____

Gas _____ Cu. Ft.

Dry Hole _____

Abandoned _____

Date

JAN 13 1937

19

S. J. LEWIS

Scout

KANSAS

Map No. 46 Sec. 5 Twp. 20 R. 10WWell No. 5 Stoltz Jr.Gulf. Company

Contractor

SECTION PLAT

0			

990 Ft. from N. Line

_____ Ft. from S. Line

_____ Ft. from E. Line

990 Ft. from W. Line

COMPLETED

Location _____

Rig up _____

Drilling and Remarks:

Sil 3291
1000 acid
Potential
1452

RECORD

Cased _____ in., _____ ft.

Sand _____

Gas _____

Oil _____

Total Depth 3301

PRODUCTION

1st 24 hrs. Nat. _____

1st 24 hrs. after shot _____

Gas _____ Cu. Ft.

Dry Hole _____

Abandoned _____

Date

FEB 17 1937 19

S. J. LEWIS Scout