

KANSAS


FORM 5-5M PETROL

Cowley

Section 23 Township 31 Range 3E

Well No. #1 O. Frye

Company Continental & Phillips

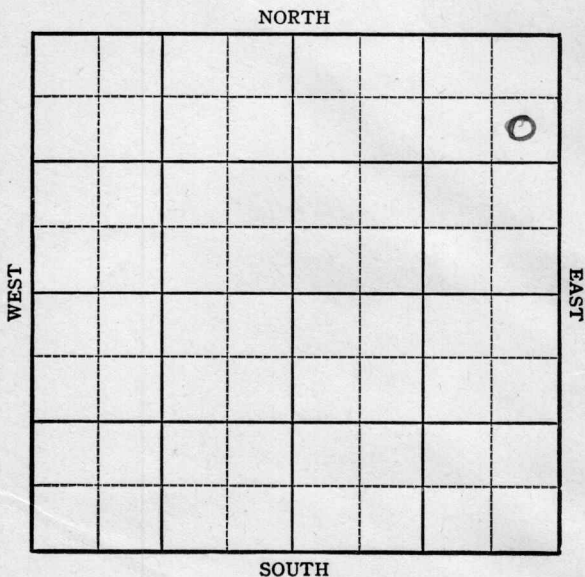

KANSAS

Cowley

Sec. 23 Twp. 31 R. 3E

Well No. #1 O. Frye Farm

Continental & Phillips Company

Miscellaneous


990 Ft. from N. Line

 Ft. from S. Line

330 Ft. from E. Line

 Ft. from W. Line

elev. 1194

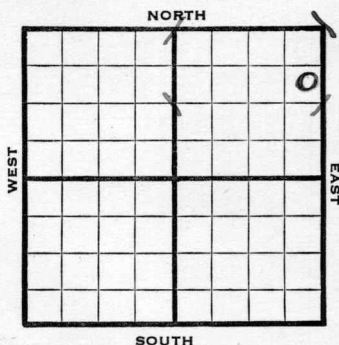

1944

R E P O R T

4/19	Location
4/26	"
5/3	"
5/10	13" @ 182 Drlg. 955
5/17	Miss. 2984
	Drlg. 3030
5/31	Arb 3342
	7" @ 3368
	TD 3368
	12 shots 3344-56
	No shots.

ABANDONED

KANSAS


Pool Name MiscellaneousMap No. / Sec. 23 Twp. 31 R. 3EWell No. 1 O. FryeContinental & Phillips Company

FIRST REPORT

Contractor

SE NE NE

SECTION PLAT

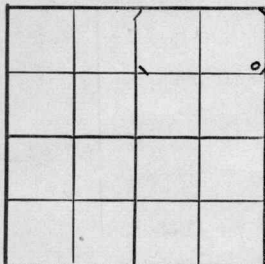990 Ft. from N. Line Ft. from S. Line330 Ft. from E. Line Ft. from W. LineCowley CountyLocation XRig up

Drilling and Remarks:

RECORD

Cased in., ft.Sand Gas Oil Total Depth

PRODUCTION

1st 24 hrs. Nat. 1st 24 hrs. after shot Gas Cu. Ft.Dry Hole Abandoned

Date

APR 19 1944 19S. J. LEWIS

Scout

KANSAS

Pool Name MiscellaneousMap No. 1 Sec. 23 Twp. 31 R. 3EWell No. 1 O. FryeContinental & Phillips Company**ABANDONED**

Contractor

SE NE NE

SECTION PLAT

			∅

990 Ft. from N. Line Ft. from S. Line330 Ft. from E. Line Ft. from W. LineCowley CountyLocation Rig up

Drilling and Remarks:

*See 3342**7" @ 3368.**12 shots 3344-56**Nocho to*

RECORD

Cased in., ft.Sand Gas Oil Total Depth 3368

PRODUCTION

1st 24 hrs. Nat. 1st 24 hrs. after shot Gas Cu. Ft.Dry Hole Abandoned

Date

MAY 31 1944

19

S. J. LEWIS

Scout