


Section 21 Township 20 Range 12 W

Well No. #1 Phillips

Company Roland Pelt et al

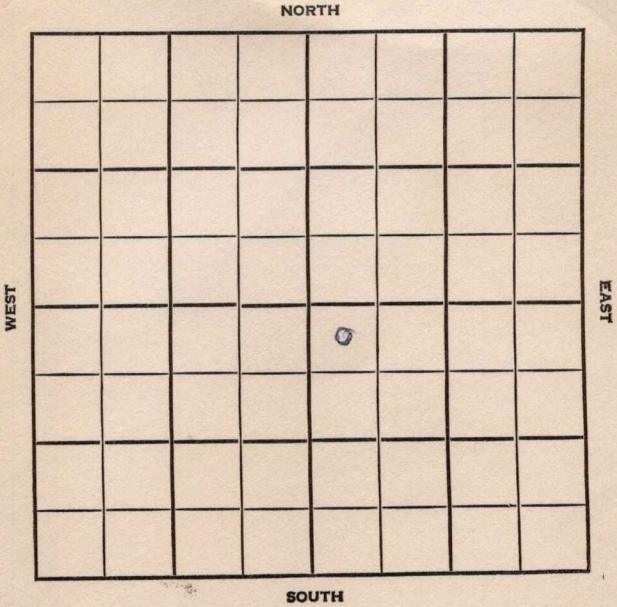

Barton

KANSAS

SEC.	TWP.	R.
21	20	12W

WELL NO.

#1 Phillips

FARM

COMPANY

Roland Pelt etal

CONTRACTOR

Garvey

WILDCAT


_____ Ft. from N. Line

_____ Ft. from S. Line

_____ Ft. from E. Line

_____ Ft. from W. Line

NW NW SE

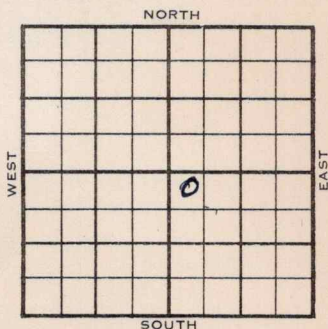

1956

ELEVATION

1838'

REPORT

3-14

Comm. 3-8-56

8" @ 225/200

Drlg. 1530

5-29

DST 3370-3445 op 36 min. rec. 45' mud, 150#

5 1/2" @ 3448

DST 3176-86 op 39 min, gas in 5 min. F/ oil in 34 min, 1020#.

DST 3235-57 op 1 hr. rec. 360' wtr., 520#.

DDB457, HFW, DD 3457, HFW,

PB 3200, 18/3167-73, 500 A.

F/ 15.2 boph, 11 hrs.

Comp. 37 gopd.

L. 3138', A. 3422'.

TD 3450'

COMPLETED

County Barton Elev. _____
 Sec. 21 Twp. 20 Rge. 12W
 Company Roland Pelt et al. (Dallas)
 Farm Name Phillips No. 1

TOPS	DEPTH	LOG	DATUM	Loc. in Sec.
Anh.				NW NW SE
Tp.				
H.				
Tr.				
Dg.				
Bl.				
L.				
K.C.				Geol. _____
B.K.C.				Contr. _____
Ce.				<u>Garvey</u>
C.				Pool _____
M.				<u>Wildcat</u>
M.				
K.				
Mz.				
Me.				
V.				
S.				
S.				
A.				
R.				
Pe.				
G.				
T.D.				



Date Comm. 3-8-56
8" @ 225/200 drlg. 1530

MAR 14 1956

15

County Barton Elev. 1838
 Sec. 21 Twp. 20 Rge. 12W
 Company Roland Pelt et al. (Dallas)
 Farm Name Phillips No. 1

TOPS	DEPTH	LOG	DATUM
Anh.			
Tp.			
H.			
Tr.			
Dg.			
Bl.			
L.	<u>3138</u>		<u>1300</u>
K.C.			
B.K.C.			
Ce.			
C.			
M.			
M.			
K.			
Mz.			
Mq.			
V.			
S.			
S.			
A.	<u>3422</u>		<u>1584</u>
R.			
PE.			
G.			
T.D.	<u>3450</u>		

Loc. in Sec. _____

NW NW SE

Geol. _____

Contr. _____

Garvey

Pool _____

Wildcat

COMPLETE

Date Comm. 3-8-56

MAY 29 1956

8" @ 225/200 DST 3370-3445 open 36 min.

rec. 45' mud 150# 5 1/2" @ 3448

DST 3176-86 open 39 min. gas in 5 min.

F/ oil in 34 min. 1020# DST 3235-57

open 1 hr. rec. 360' wtr. 520#

DD 3457 HFW DD 3457 HFW PB 3200

18/ 3167-73 500 A F/ 15.2 boph 11 hr

Comp. 37 bopd

Twp. ~~Pool~~
Co. ~~Facet~~

S-513-B

County Barton Elev. 1844.05
Sec. 21 Twp. 29 Rge. 12W
Company Rowland L. Pelt
Farm Name Phillips No. 4

TOPS	DEPTH	LOG	DATUM
Anh.			
Tp.			
H.		3030	
Tr.			
Dg.			
B.L.		3157	
L.		3169	
K.C.			
B.K.C.			
Ce.			
C.			
M.			
M.			
K.			
Mz.			
Mq.			
V.			
S.			
S.			
A.		3410	
R.			
Pf.			
G.			
T.D.	3495		

Loc. in Sec. NW SW SE
Geol. _____
Contr. Honaker-Davis
Pool Workman NW

COMPLETE
APR 23 '58

Date Comm. 1-16-58 8 1/2 248/200
Location JAN 29 '58 DST 3190-3218 60"
120' OCM 15W BHP 500 h2
5 1/2 3495/125 CO per 23445-50
FEB 5 '58 250 A \$ 4430 44BW 24h
POB P 3 B FPH 9090 W FEB 12 '58
P 4730 + 1090 W 24h FEB 19 '58
FEB 26 '58 POB MAR 5 '58 MAR 12 '58 MAR 19 '58 MAR 26 '58
APR 2 '58 APR 9 '58 APR 16 '58 APR 23 '58 59 3445-50
45 sks 12/3442-45 NO to 750A
see L6 \$ 2130 PH NW 11T 1000' OB

POB P87 126 BOD2 NW
 on 40.2°
 Arb 3