

Cowley


KANSAS

SECTION 24 TOWNSHIP 31S RANGE 3E

WELL NO. #2 Holderness

COMPANY Shawver-Armour

NORTH SE NE NW

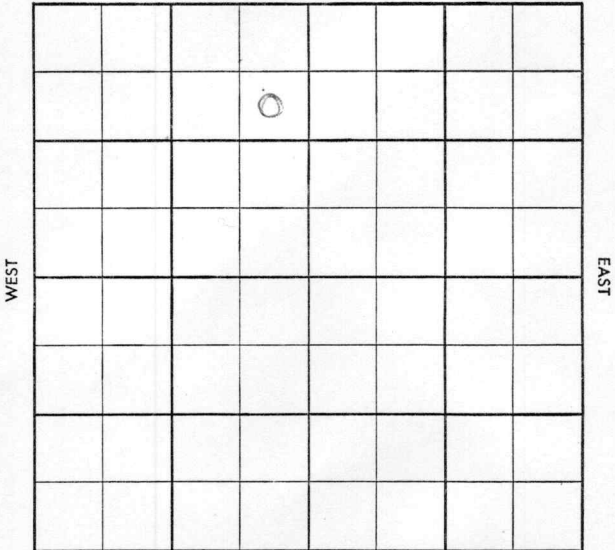

SOUTH

X X
X 25

County Cowley Elev. _____
 Sec. 24 Twp. 31 Rge. 3E
 Company Shawver-Armour
 Farm Name Holderness No. 2

TOPS	DEPTH	LOG	DATUM
Anh.			
Tp.			
H.			
Tr.			
Dg.			
B.L.			
L.			
K.C.			
B.K.C.			
Ce.			
C.			
M.			
M.			
K.			
Mz.			
Mq.			
V.			
S.			
S.			
A.			
R.			
Pf.			
G.			
T.D.			

Loc. in Sec. _____
SE NE NW

Geol. _____
 Contr. _____
 Co. Tools # 2

Pool _____
Clark

FIRST REPORT
JUL 30 '58

Date Comm. _____
MIRT

Co.

Lse.

No.

Sec.

T.

R.

Twp. NO Pool NO
Co. NO Field NO

29

S-513-B

County Cowley Elev. 1204 DE 1207 DE
Sec. 24 Twp. 31 Rge. 3E
Company Shawver-Armour
Farm Name Holderness No. 2

TOPS	DEPTH	LOG	DATUM
Anh. <u>Sta 1</u>	<u>1997</u>		
Tp. <u>Loy</u>	<u>2232</u>		
H.			
Tr.			
Dg.			
B.L.			
L. <u>K2</u>	<u>2404</u>		
K.C.	<u>2394</u>		
B.K.C.	<u>2657</u>		
Ce. <u>cler</u>	<u>2664</u>		
C. <u>OSW</u>	<u>2709</u>		
M. <u>Bart</u>	<u>2930</u>		
M.			
K.			
Mz.			
Mq.			
V.			
S.			
S.			
A.			
R.			
Pf.			
G.			
T.D.	<u>2980</u>		

Loc. in Sec. SE NE NW

Geol.

Contr.

Co. Tools 25

Pool

Clark

COMPLETE

SEP 3 '58

Date Comm. 7-30-58 8" 190/150

MIRT Aug 6 2572 AUG 13 '58

Cov 2928-60 5" 2979/160

AUG 20 '58 AUG 27 '58 SEP 3 '58 25/2940-44

25/2948-52 24/2952-56 23/

2944-48 FU 1000' oil 3hrs

from 20,000 x 13,400 sec pop

P 25 BOPd NW

4