

KANSAS


Rice

FORM 51 5M PETROL

Section 16 Township 20 Range 9W

Well No. 4 Argo Smith

Company C. U. Bay

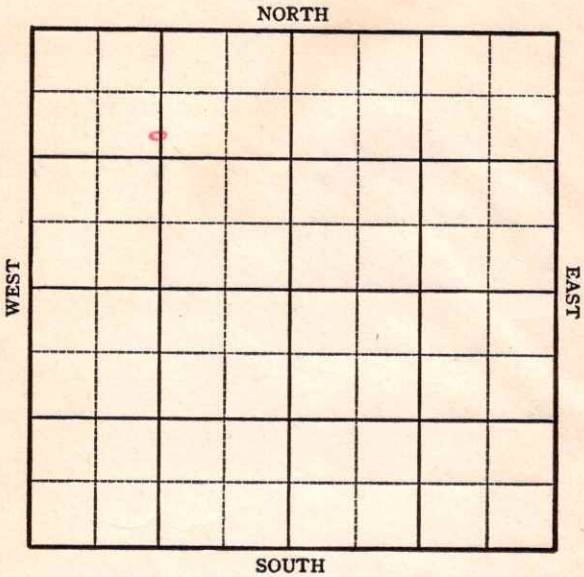

KANSAS

Rice

Sec. 16 Twp. 20 R. 9-W

Well No. #4 Argo Smith Farm


C. U. Bay Company

990 Ft. from N. Line

Ft. from S. Line

1320 Ft. from E. Line

Ft. from W. Line

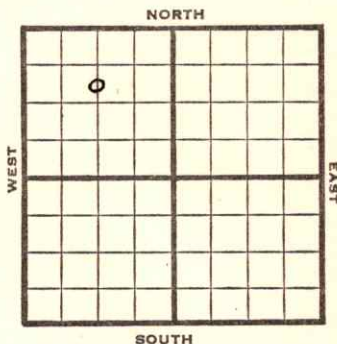

C S L $N\frac{1}{2}$ NW

1945 **Elev. 1742**

REPORT

11/7 Location

11/14 8" @ 198
Drlg. 1800'

11/21 **Arb. 3257**
TD 3262'
5" @ 3259' RUST
" " "

11/28

12/5 TD 3271
500 acid.

12/12 " "

12/20 " "


12/28 **Arb. 3257**
5" @ 3259
1000 acid.

TD 3271
Pump 50 Pot.
Grav. 42.0

COMPLETED

KANSAS

Kansas

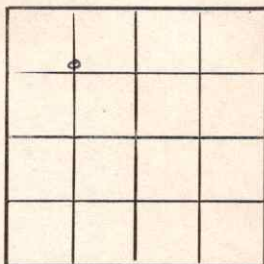Pool Name SilicaMap No. 49 Sec. 16 Twp. 20 R. 9WWell No. 4 Argo SmithC. U. Bay Company**FIRST REPORT** ContractorC S L N $\frac{1}{2}$ NW**SECTION PLAT**990 Ft. from N. Line

Ft. from S. Line

1320 Ft. from E. Line

Ft. from W. Line

Rice CountyLocation x

Rig up

Drilling and Remarks:

RECORD

Cased _____ in., _____ ft.

Sand _____

Gas _____

Oil _____

Total Depth _____

PRODUCTION

1st 24 hrs. Nat. _____

1st 24 hrs. after shot _____

Gas _____ Cu. Ft.

Dry Hole _____

Abandoned _____

Date

NOV 7 1945 19S. J. LEWIS

Scout

KANSASPool Name SilicaMap No. K-49 Sec. 16 Twp. 20 R. 9WWell No. 4 Argo SmithC. U. Bay

Company

COMPLETED


Contractor

C S L N $\frac{1}{2}$ NWE1,1742**SECTION PLAT**990 Ft. from N. Line

Ft. from S. Line

1320 Ft. from E. Line

Ft. from W. Line

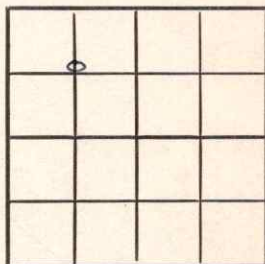Rice County

Location

Rig up

Drilling and Remarks:


Cased _____ in., _____ ft.

Sand _____

Gas _____

Oil _____

Total Depth 9271**PRODUCTION**

1st 24 hrs. Nat. _____

1st 24 hrs. after shot _____

Gas _____ Cu. Ft.

Dry Hole _____

Abandoned _____

Date

DEC 28 194519S. J. LEWISScout