

Rice


KANSAS

Form 51—5M—11-38—Palace

Section 5 Township 20 Range 10-W

Well No. 10 Dews

Company J. H. Tatlock

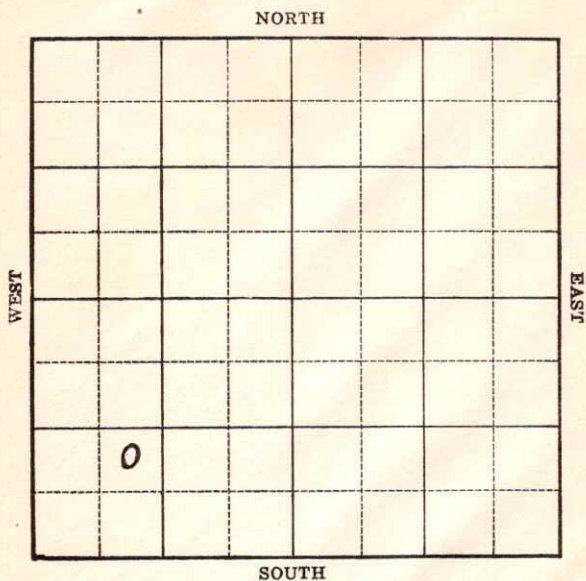

Rice

KANSAS

Map No. 46 Sec. 5 Twp. 20 R. 10WWell No. 10 DrowsJ. H. Tatlock

Company

Contractor

FIRST REPORT

NE SW SW

Ft. from N. Line

990 Ft. from S. Line

Ft. from E. Line

990 Ft. from W. Line

SECTION PLAT

0			

Location

Rig up

Drilling and Remarks:

10" - 146'WOC

RECORD

Cased _____ in., _____ ft.

Sand _____

Gas _____

Oil _____

Total Depth _____

PRODUCTION

1st 24 hrs. Nat. _____

1st 24 hrs. after shot _____

Gas _____ Cu. Ft.

Dry Hole _____

Abandoned _____

Date

DEC 13 1938

19

H. D. Hatfield

Scout

Rice

KANSAS

Map No. 46 Sec. 5 Twp. 20 R. 10WWell No. 10 DewsJ. H. Tatlock

Company

Contractor

COMPLETED

NE SW SW

 Ft. from N. Line990 Ft. from S. Line Ft. from E. Line990 Ft. from W. Line

SILICA, POOL

SECTION PLAT

0			

Location Rig up

Drilling and Remarks:

1000 acid8-10 7/8POT 320

RECORD

Cased 7 in., 3328 ft.Sand Arb 3328Gas Oil Total Depth 3334

PRODUCTION

1st 24 hrs. Nat. 1st 24 hrs. after shot Gas Cu. Ft.Dry Hole Abandoned

Date

JAN 4 - 1939

19

H. D. Hatfield

Scout